


# Groundwater Application for Randall and Gina Rice 35S-3W-05-Tax Lot 107

Place of Use:  
 NW/NE: 5.1 Acres of Nursery  
 NE/NE: 4.9 Acres of Nursery  
 NE/NE: 1 Acre Feet of Multi-Purpose Storage

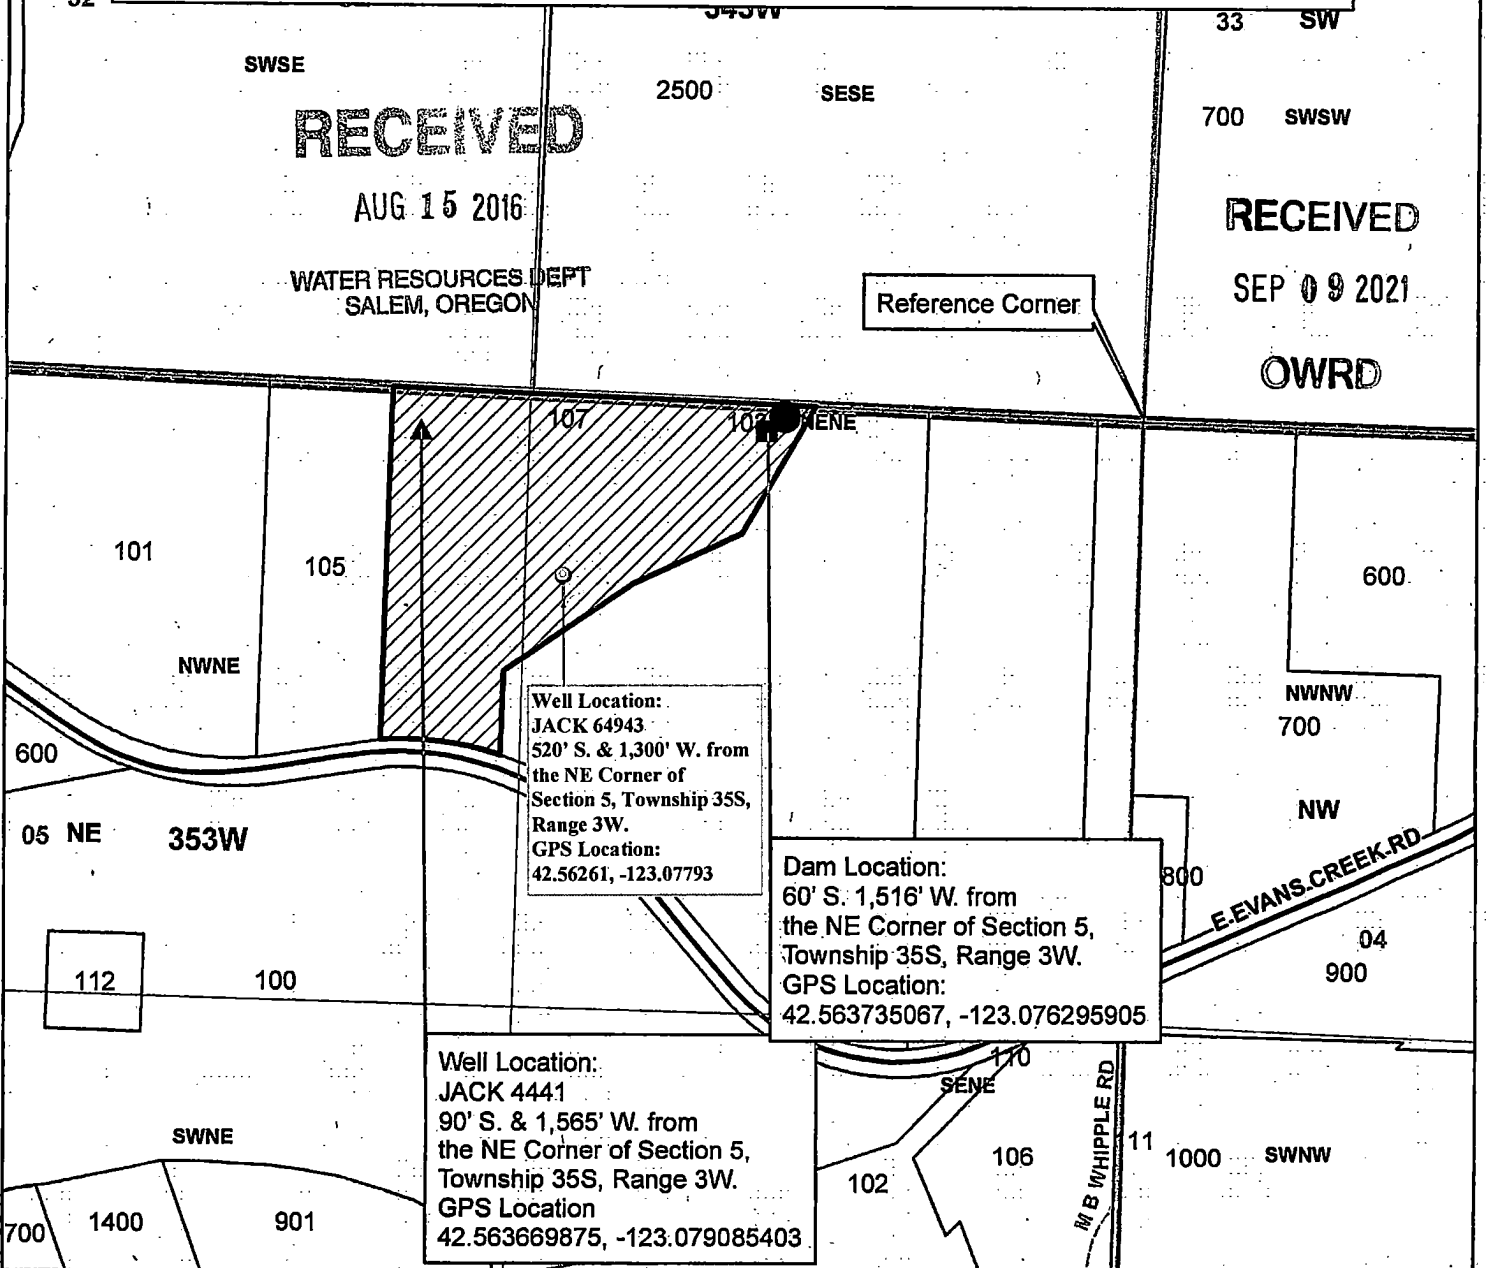

**RECEIVED**

AUG 15 2016

WATER RESOURCES DEPT  
 SALEM, OREGON

Reference Corner

**RECEIVED**


SEP 09 2021

OWRD

**Legend**

- Lake Montana
- Dam Location
- ▲ Well Location
- ▨ Place of Use
- Taxlot 107
- Taxlots
- ▭ Townships
- ▭ Sections
- ▭ Quarter Sections
- ▭ Quarter Quarter Sections
- ⊙ Additional Well Location

1 inch = 400 feet

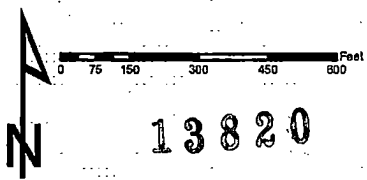

JACKSON COUNTY  
**WATERMASTER**

Prepared by Travis Kelly

This map is based on a digital database compiled by Jackson County from a variety of sources. Jackson County cannot accept responsibility for errors, omissions, or positional accuracy. There are no warranties, expressed or implied.

6-10867