


# FINAL PROOF SURVEY MAP

## RAINBOW HEIGHTS HOMEOWNERS ASSOCIATION Application G-16018 Permit G-16042


### T 8 S R 3 W, W.M. Section 27

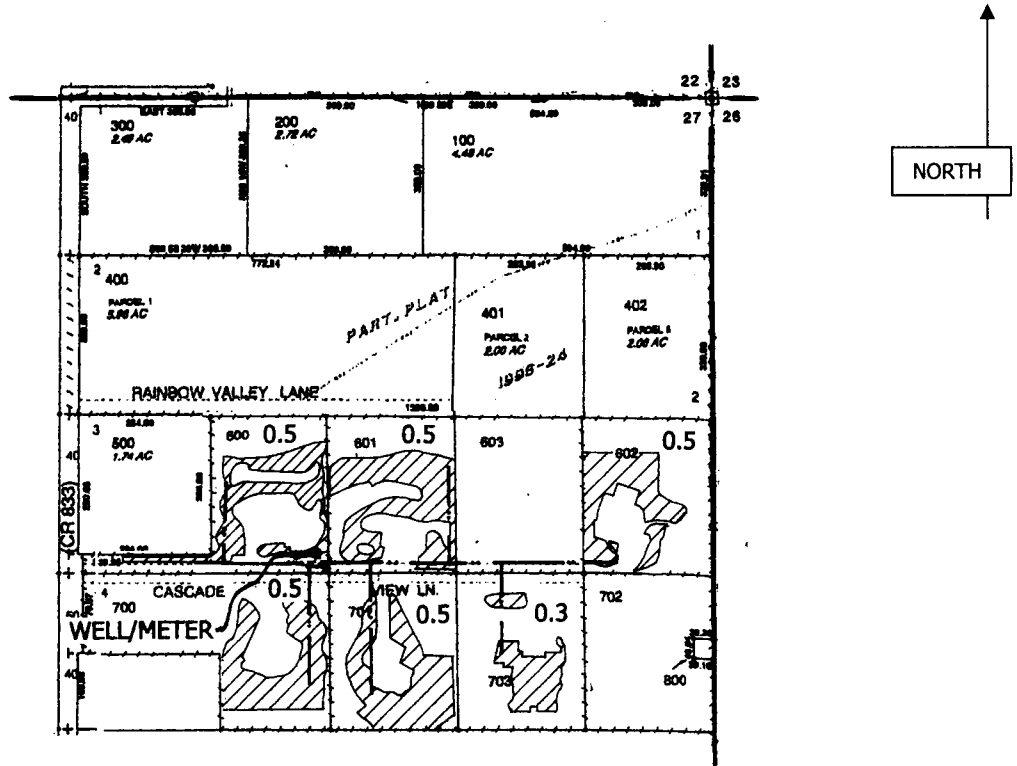

Well/Meter ●  
Section Line ———  
Tax Lot Line —+—+—+—  
Pipe line — · — · —

Well/Meter: 945' S & 820' W  
Both from the NE corner Section 27

Scale 1" = 400'

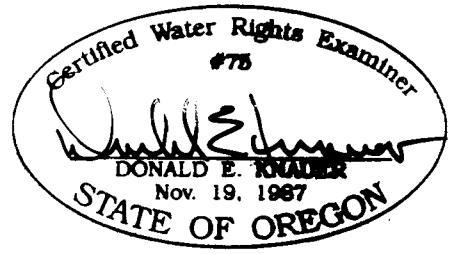

This map is not intended to provide legal dimensions or locations of property ownership

RENEWAL DATE: 6/30/2011