


County: Benton

Township: 12 S

Range: 5 W



Surbow Farm LLC. Nathan Johnson

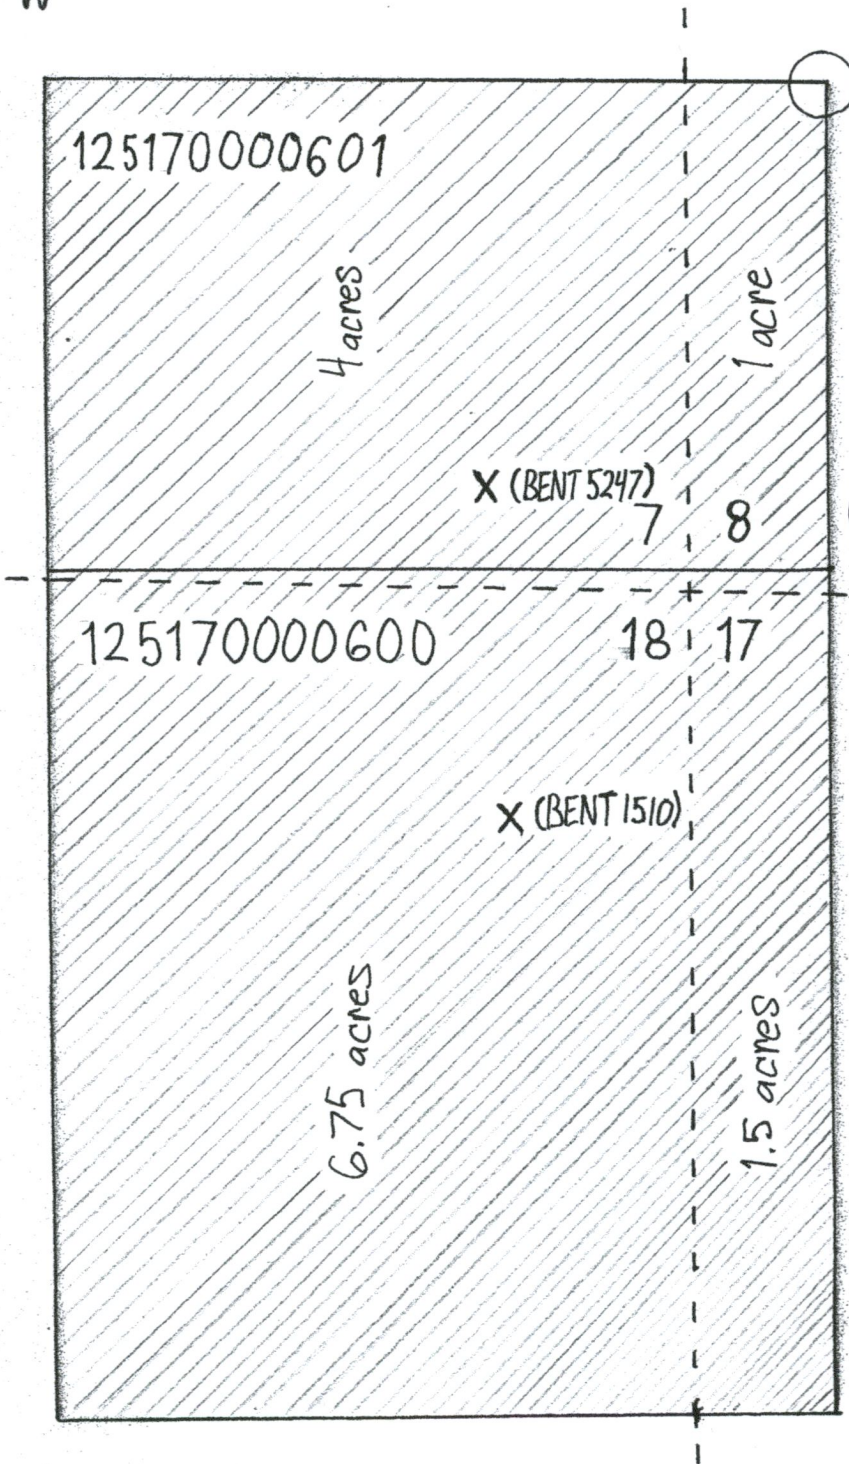

From NE corner of section 18

72' N, 145' W

BENT 5247

~~301 ft. S, 259 ft. W~~

GPS

N44.53403

W123.33309

BENT 1510

~~542 ft. S, 233 ft. W~~

~~171' S, 124' W~~

GPS

N44.53338

W123.33299

RECEIVED

MAR 02 2020

OWRD

□ Taxlots

- - Section lines

○ Reference corner

X Point of diversion (Well report)

1" = 150 ft.

▨ Area of use