



Monte Minchow Permit Amendment for
 38S-1W-28-tax lot 1400
 8 Acres of Nursery Uses in NW/SW

RECEIVED
 MAY 17 2021
 OWRD

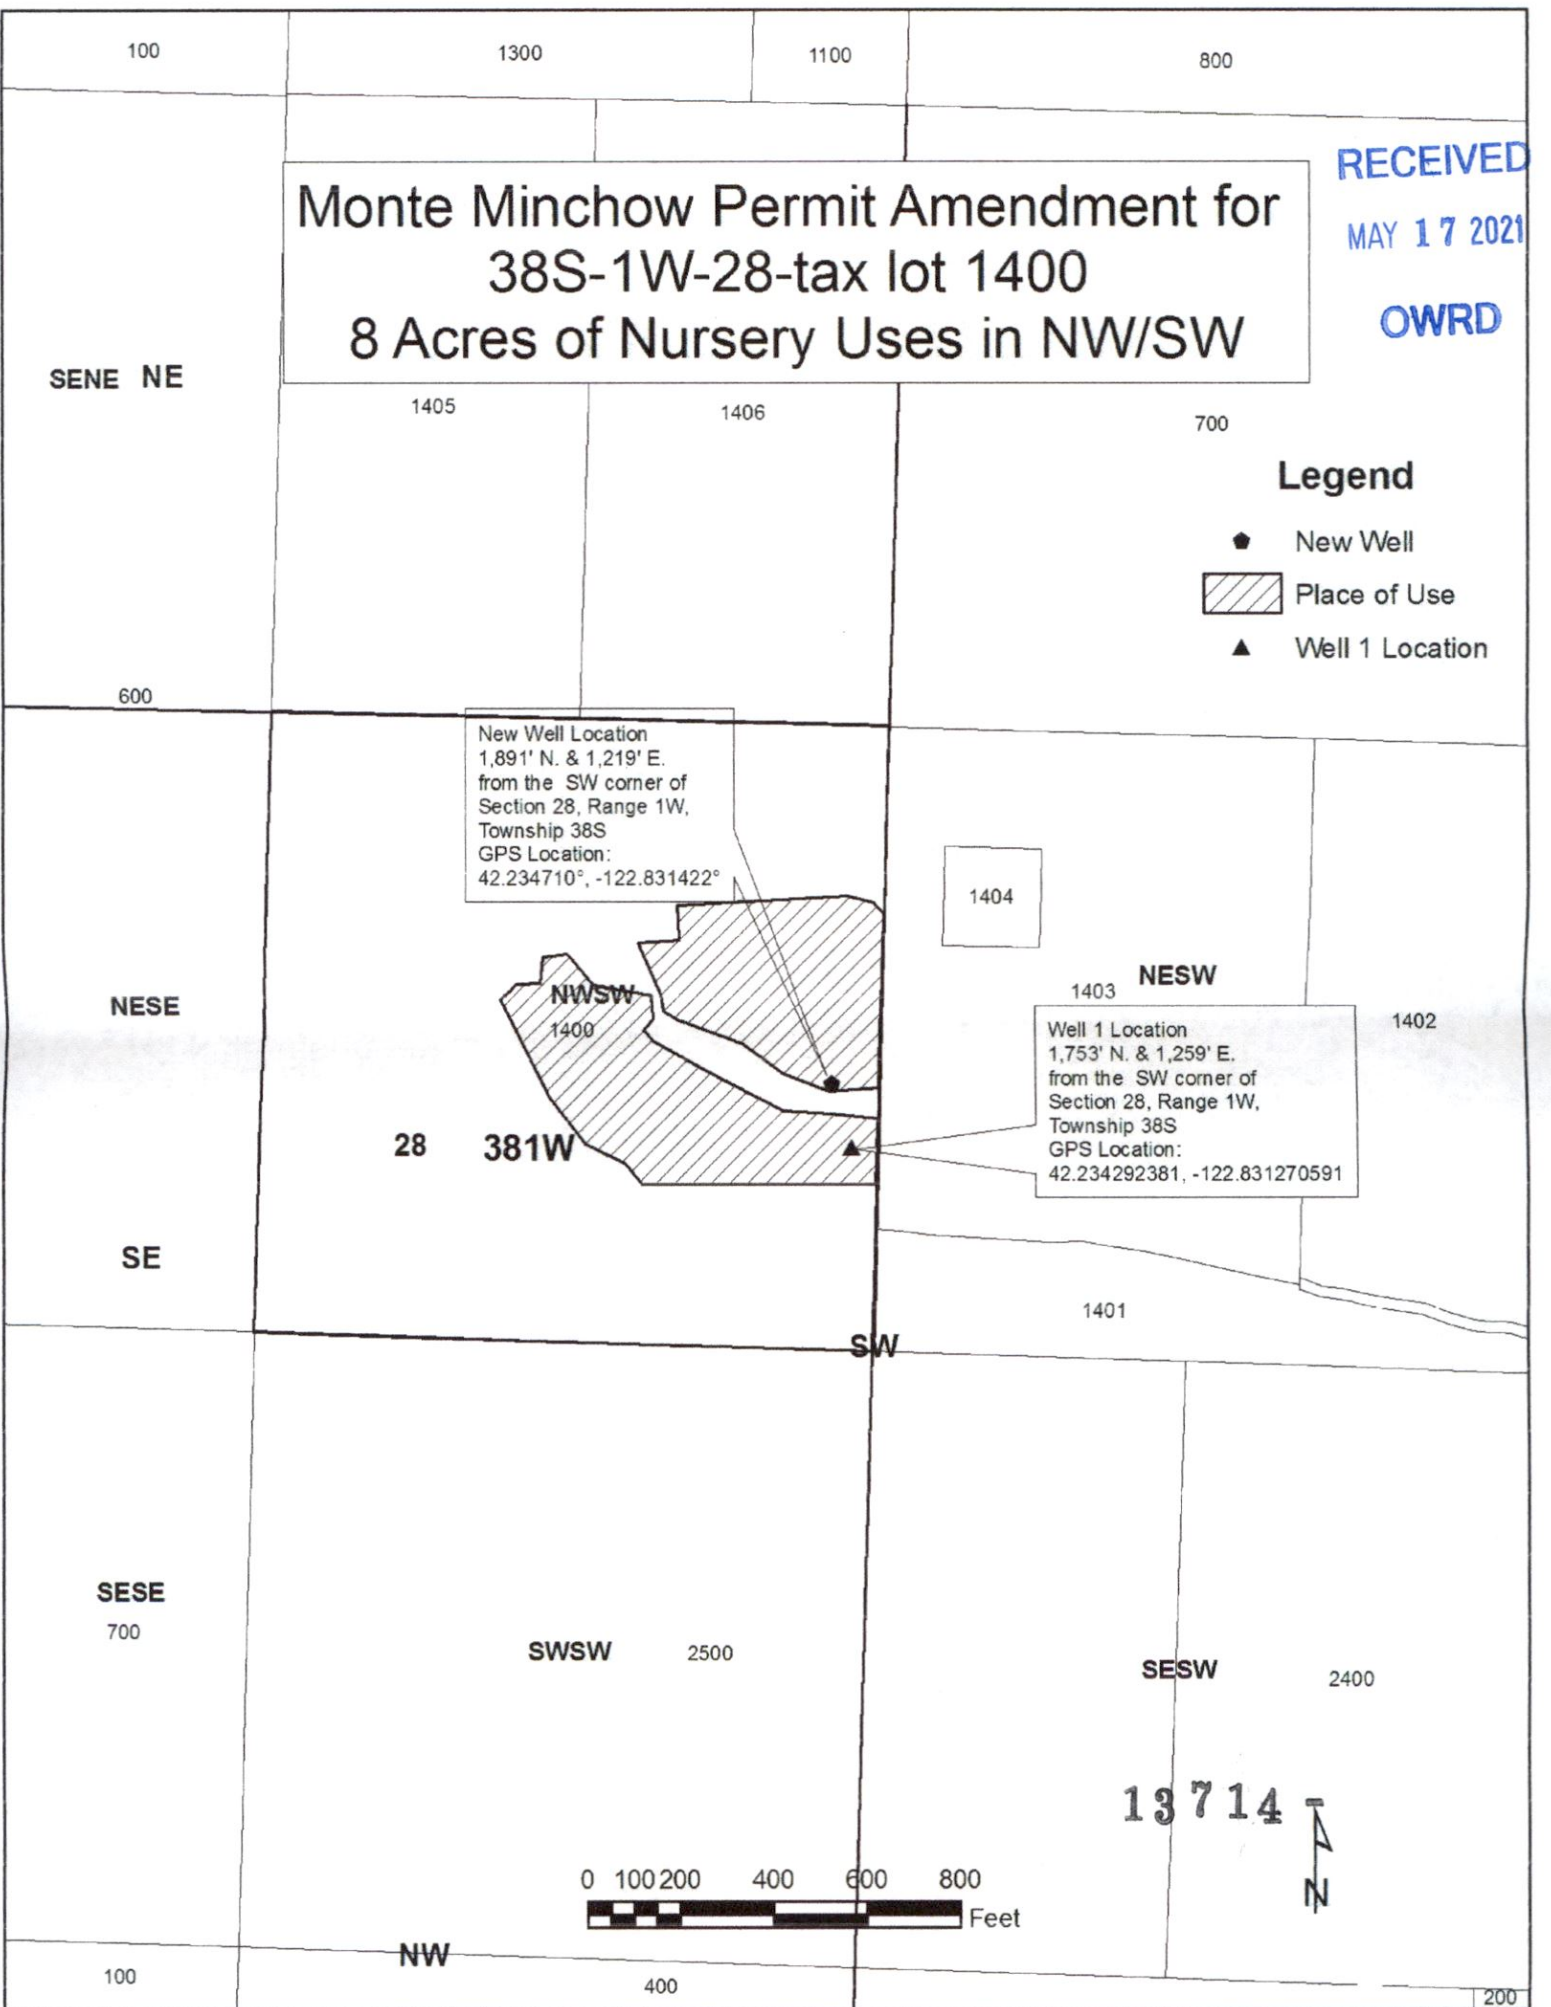

New Well Location
 1,891' N. & 1,219' E.
 from the SW corner of
 Section 28, Range 1W,
 Township 38S
 GPS Location:
 42.234710°, -122.831422°

Well 1 Location
 1,753' N. & 1,259' E.
 from the SW corner of
 Section 28, Range 1W,
 Township 38S
 GPS Location:
 42.234292381, -122.831270591

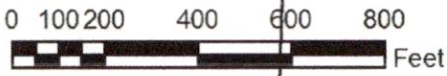

13714