



# T.3S. R.1E. Section 19, W.M.

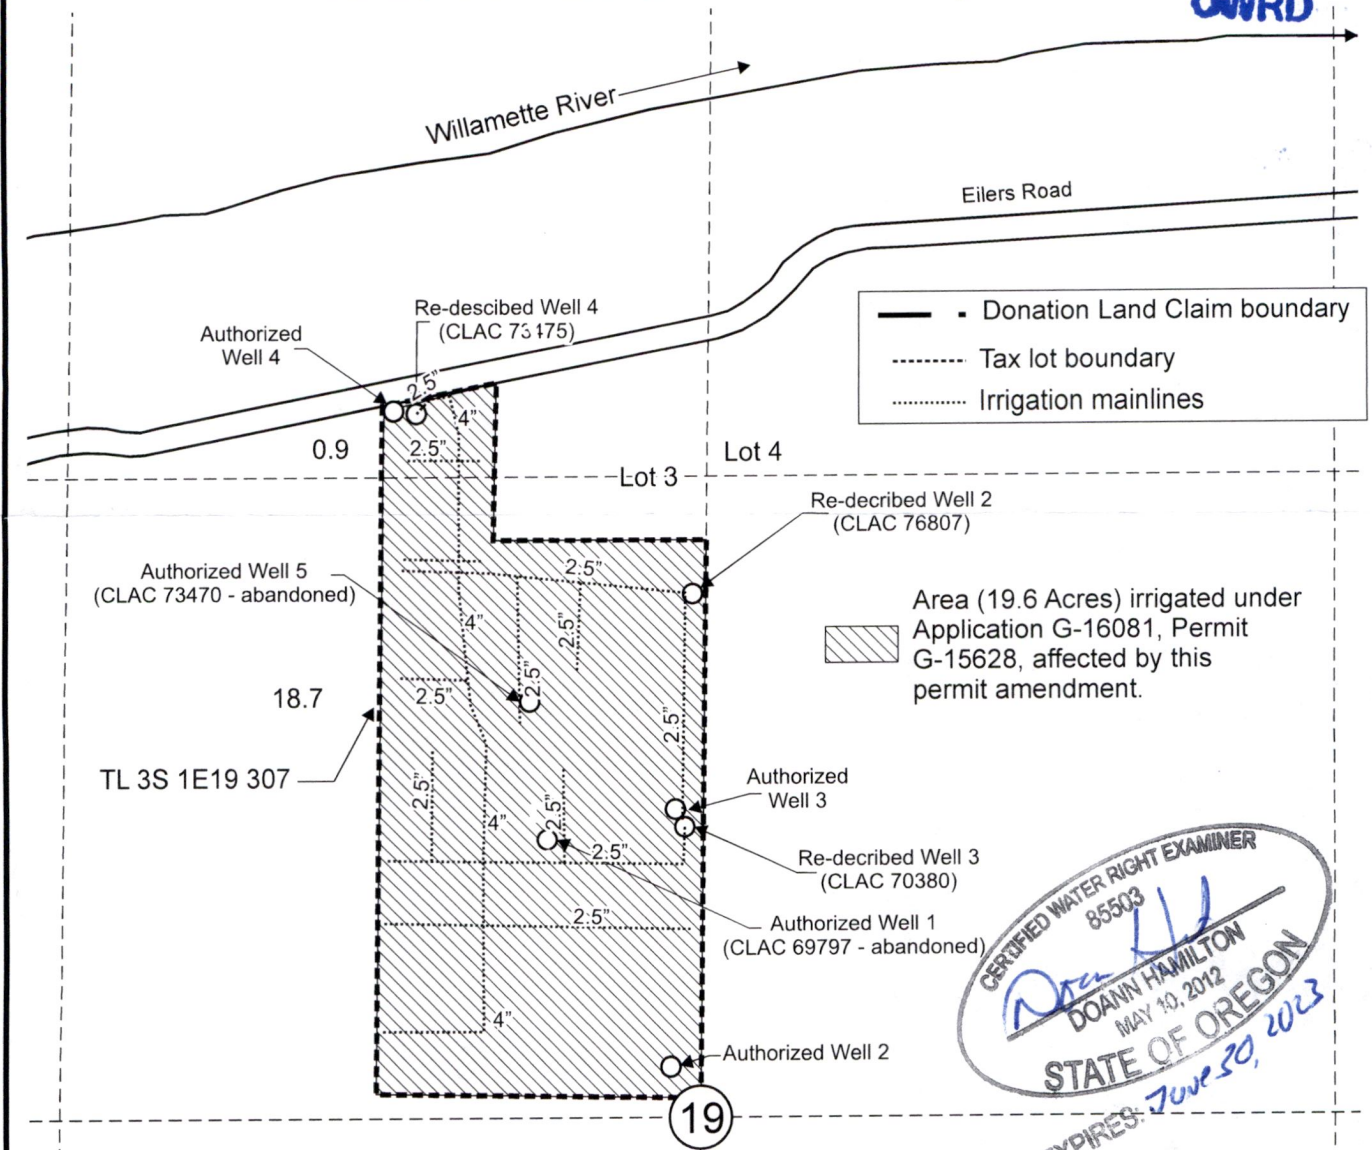

CERTIFIED WATER RIGHT EXAMINER  
 85503  
*Doann Hamilton*  
 DOANN HAMILTON  
 MAY 10, 2012  
 STATE OF OREGON  
 EXPIRES: June 30, 2023

- Authorized Well 1 (CLAC 69797 - abandoned) is located 600 feet north and 290 feet west from the center, Section 19.
- Authorized Well 2 is located 120 feet north and 30 feet west from the center, Section 19.
- Re-described Well 2 (CLAC 76807) is located 1,080 feet north and 15 feet west from the center, Section 19.
- Authorized Well 3 is located 655 feet north and 25 feet west from the center, Section 19.
- Re-described Well 3 (CLAC 70380) is located 600 feet north and 30 feet west from the center, Section 19.
- Authorized Well 4 is located 1,475 feet north and 605 feet west from the center, Section 19.
- Re-described Well 4 (CLAC 73475) is located 1,455 feet north and 590 feet west from the center, Section 19.
- Authorized Well 5 (CLAC 73470 - abandoned) is located 875 feet north and 335 feet west from the center, Section 19.

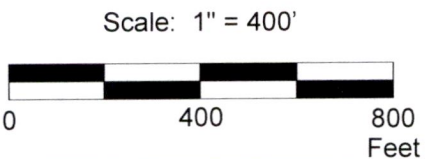

This map was prepared for the purpose of identifying the location of a water right only and is not intended to provide legal dimensions or location of property ownership lines.

## Permit Amendment Map

### Application G-16081, Permit G-17787

Keith Ketch DeKanter  
 T.3S. R.1E. Section 19, W.M.

Pacific Hydro-Geology Inc.

DeKanter2ndPAMap.cdr