



Figure 1
Permit Amendment Application
Change of POA

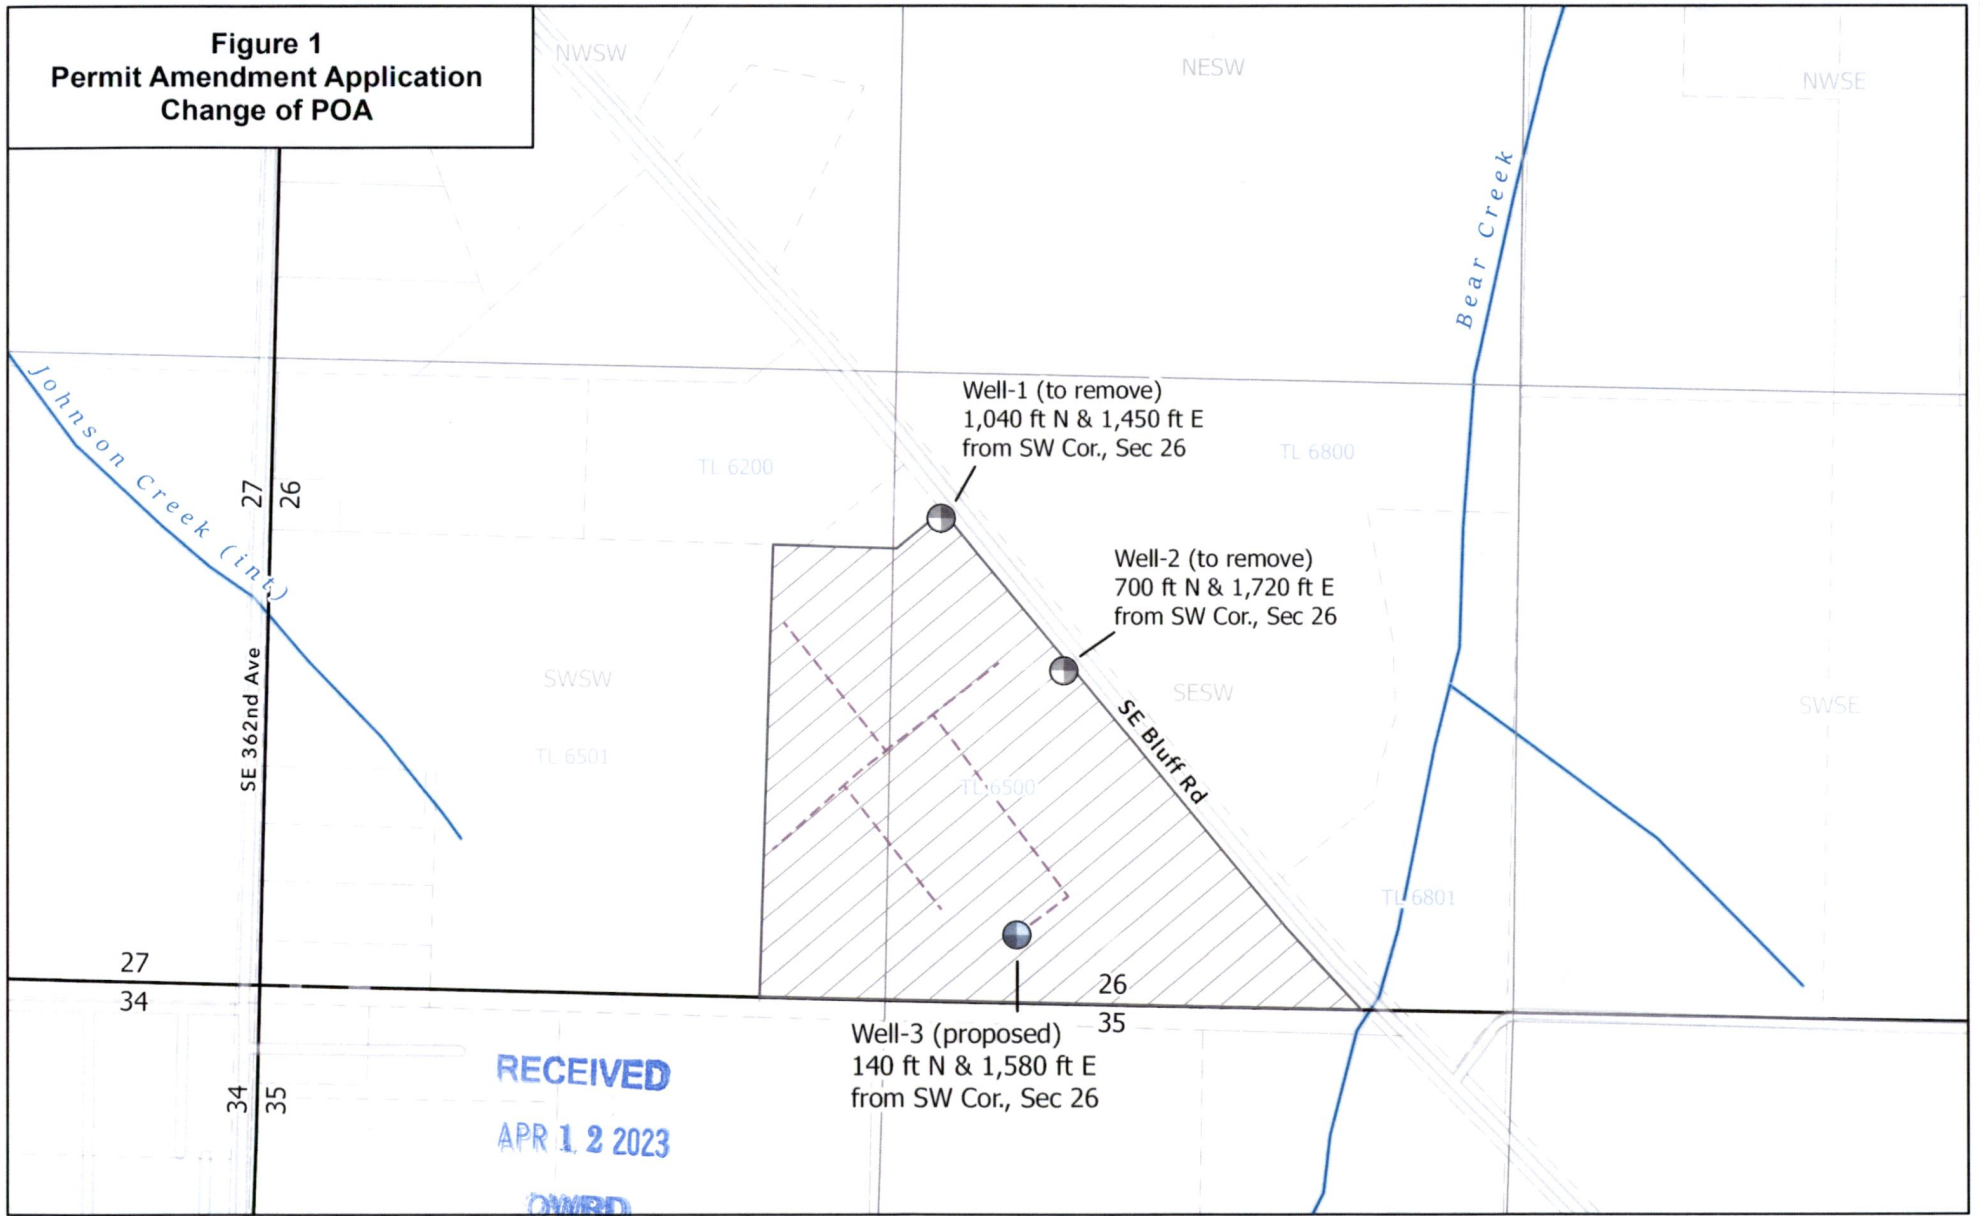

1319 SE MLK Jr. Blvd, Suite 204
 Portland, Oregon 97214
 (503) 954-1326

Permit Amendment Application
Change of POA (Well-3)
T1S, R4E, Section 26, SWSW-SESW

1	DATE	AUTH	DRAFT
No.	Date	By	Revisions

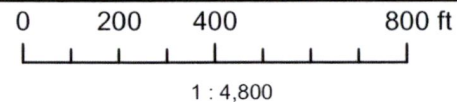

- Existing POAs
- Proposed POA
- G-15779 POU
- Mainlines
- Taxlots

Proj#: 2305001
Diamond Nursery
 Barry & Lee Ann Cook
 37621 SE Bear Creek Lane
 Boring, OR 97009

