# PERMIT AMENDMENT MAP FOR CITY OF MONMOUTH MAY 5, 2023

SCALE: 1" = 1320' 0"

APPLICATION: G-8926
PERMIT NO: G-8579

NOTE: MAP IS FOR SOLE PURPOSE OF IDENTIFYING LOCATION OF WATER RIGHT AND HAS NO INTENT TO DIMENSION OR LOCATE ANY PROPERTY OWNERSHIP LINES

SIGNIFIES AREA OF POINT OF USE
CITY LIMITS
URBAN GROWTH BOUNDARY (WATER USE AREA)

T8S, R5W W.M.

T8S, R4W W.M.

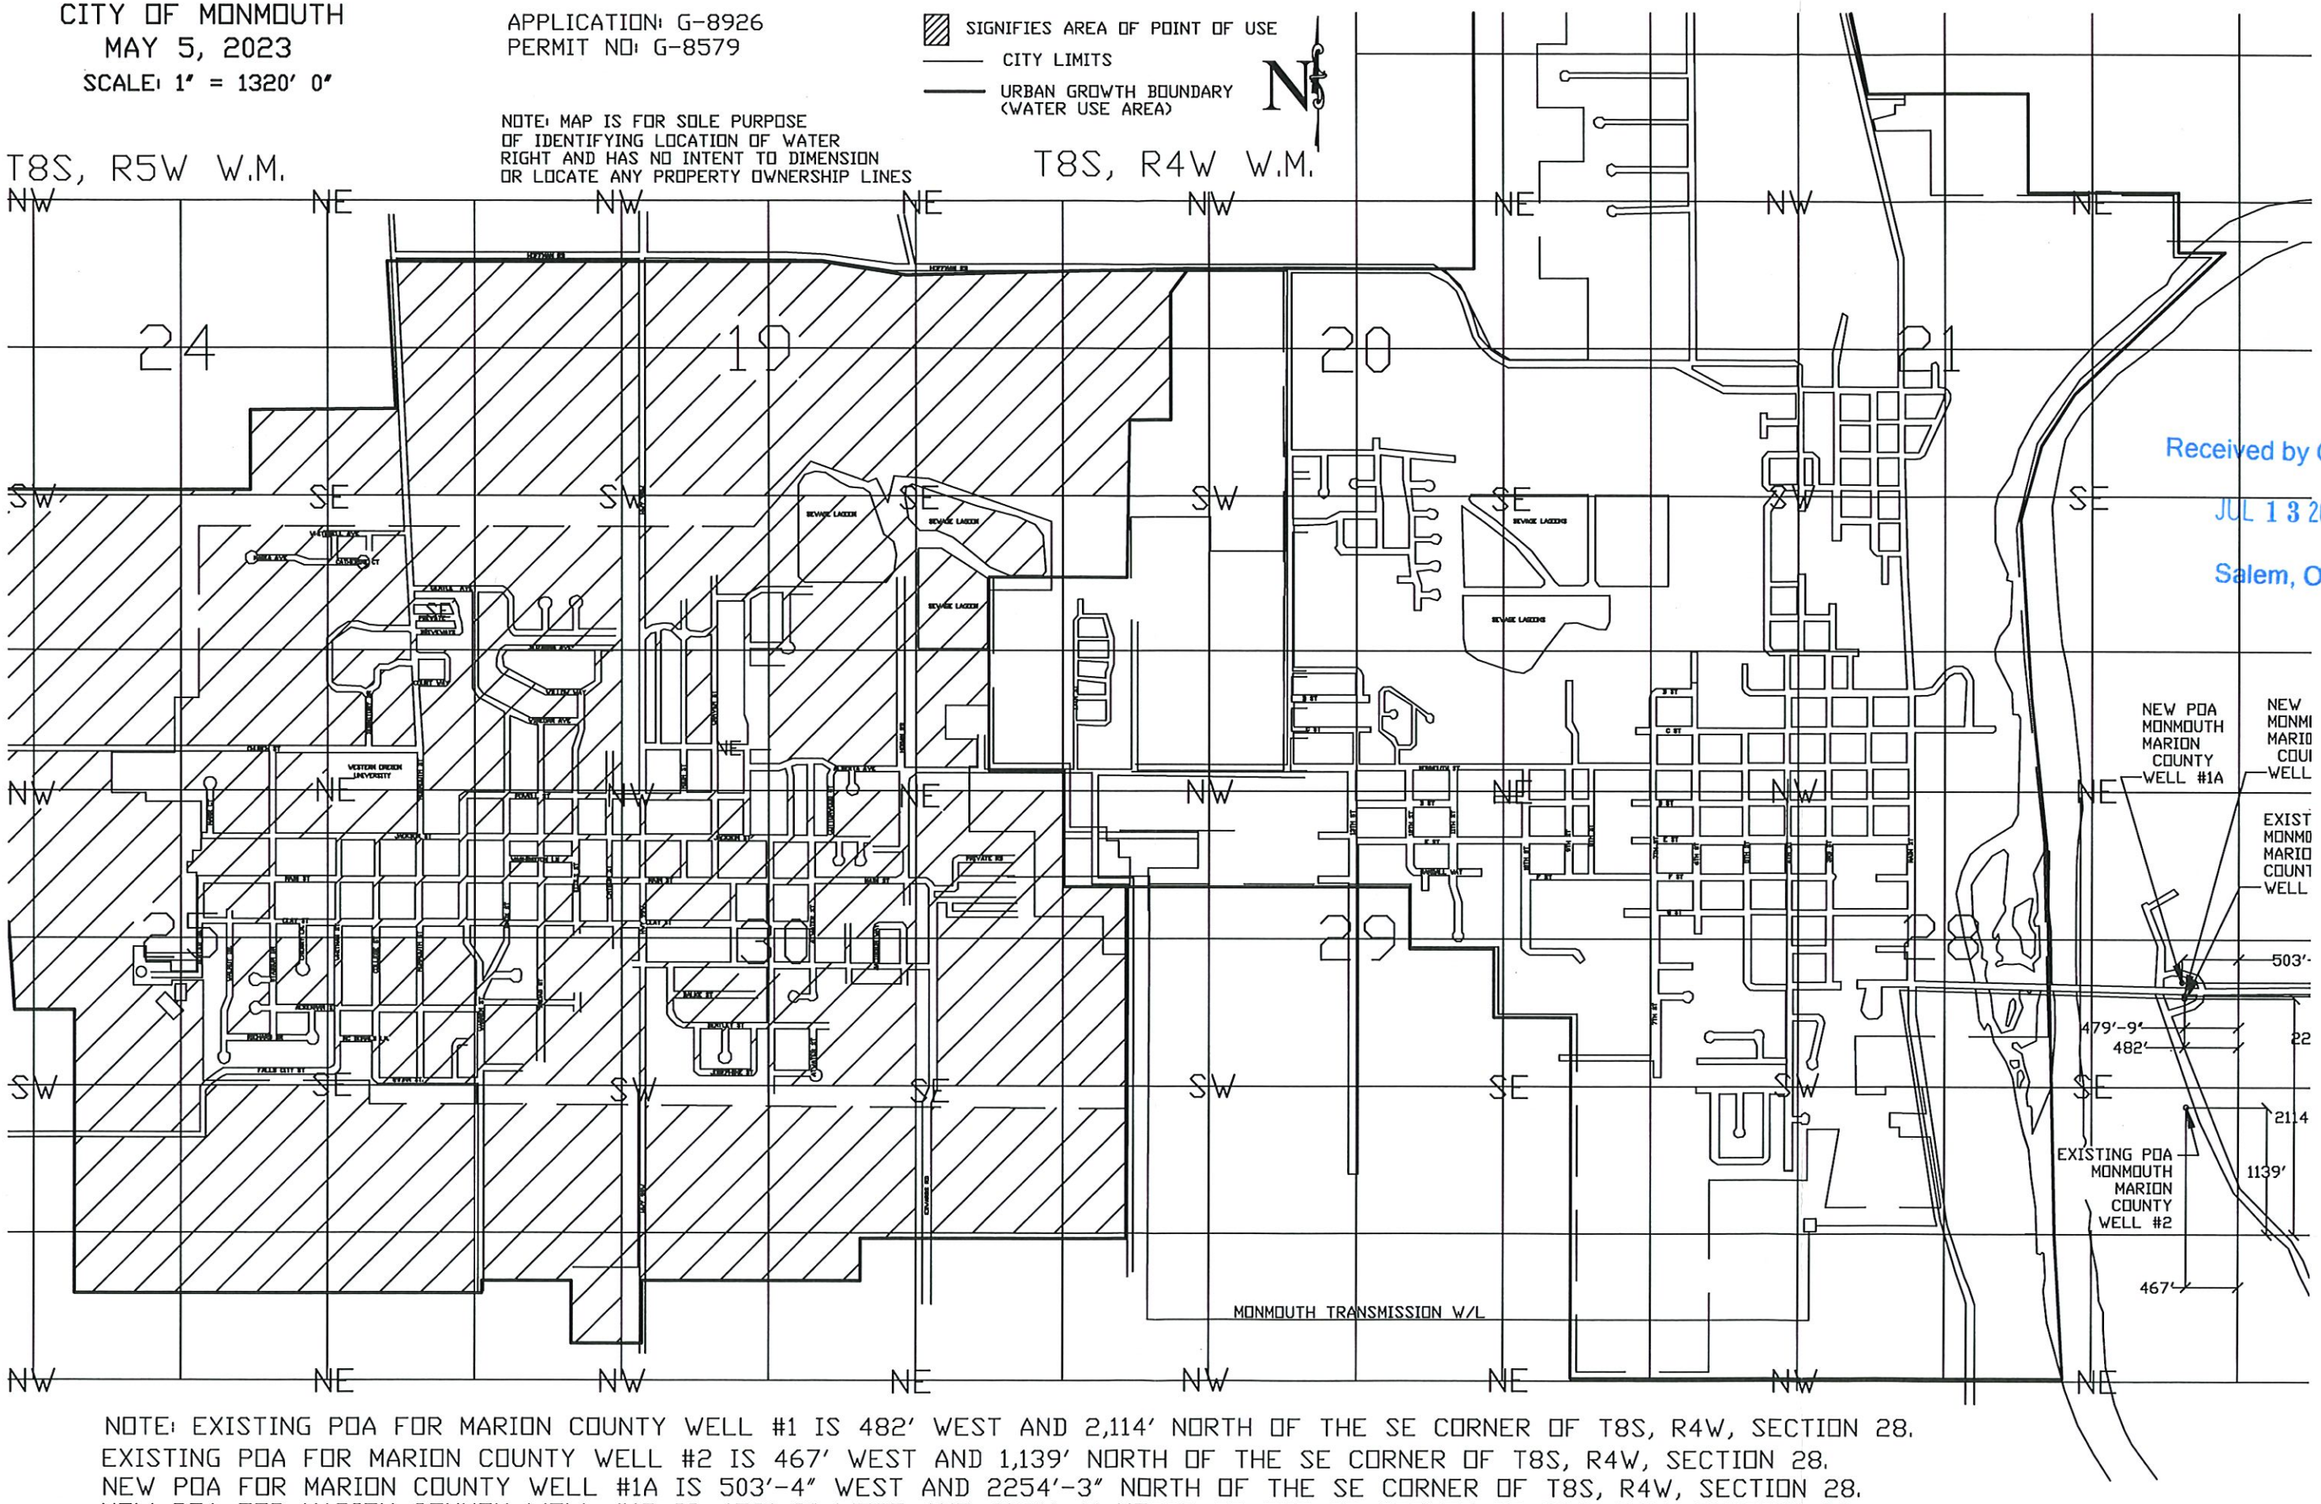


Received by OWRD
JUL 13 2023
Salem, OR

NOTE: EXISTING POA FOR MARION COUNTY WELL #1 IS 482' WEST AND 2,114' NORTH OF THE SE CORNER OF T8S, R4W, SECTION 28.
EXISTING POA FOR MARION COUNTY WELL #2 IS 467' WEST AND 1,139' NORTH OF THE SE CORNER OF T8S, R4W, SECTION 28.
NEW POA FOR MARION COUNTY WELL #1A IS 503'-4" WEST AND 2254'-3" NORTH OF THE SE CORNER OF T8S, R4W, SECTION 28.
NEW POA FOR MARION COUNTY WELL #1B IS 479'-9" WEST AND 2138'-4" NORTH OF THE SE CORNER OF T8S, R4W, SECTION 28.