


STATE ENGINEER
OREGON

Note: Well monument consists of 2"x2" wood stake.

N $\frac{1}{2}$ SW $\frac{1}{4}$ Sect. 33
T4N, R27E

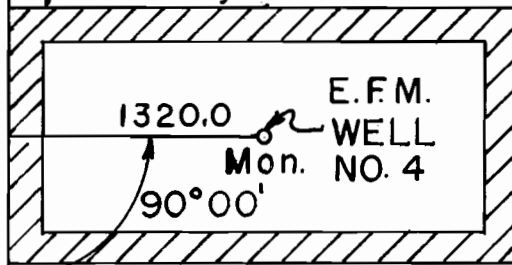

Limits of area to be irrigated from proposed well.

1980.0

32 33
5 4

G.L.O. Monument

T4N
T3N

SECTION 33, T4N, R27EWM

Scale: 1"=1000' Application No. G-279
Permit No. G-199

I, J. C. Payne of
Pendleton, Oregon do hereby
certify that this map was made
from notes take during an
actual survey made by me (or
under my immediate supervision
on March 11, 1956

J. C. Payne
Surveyor

WELL LOCATION MAP
FOR E.F. McDOLE
MORROW COUNTY, OREGON