

Scale 1" = 300'


PLAT OF VARIOUS AREAS OF WATER USE

- IRRIGATED ACREAGE
- RECREATIONAL ACREAGE
- DOMESTIC USE.

RECEIVED  
NOV 7 1961  
STATE ENGINEER  
SALEM, OREGON

Application No. G-2114  
Permit No. G-1950


AZUSA • CALIFORNIA REAL ESTATE • BUILDERS • LAND DEVELOPMENT			
S 1/2 Sec 10	T-275 R-17E		
SW 1/4 Sec 11	NW 1/4 Sec 14	PLAN	
N 1/2 Sec 15			
Aug 15,	DEW		
DATE	DWN. BY	REVISED	SHEET
			1-1

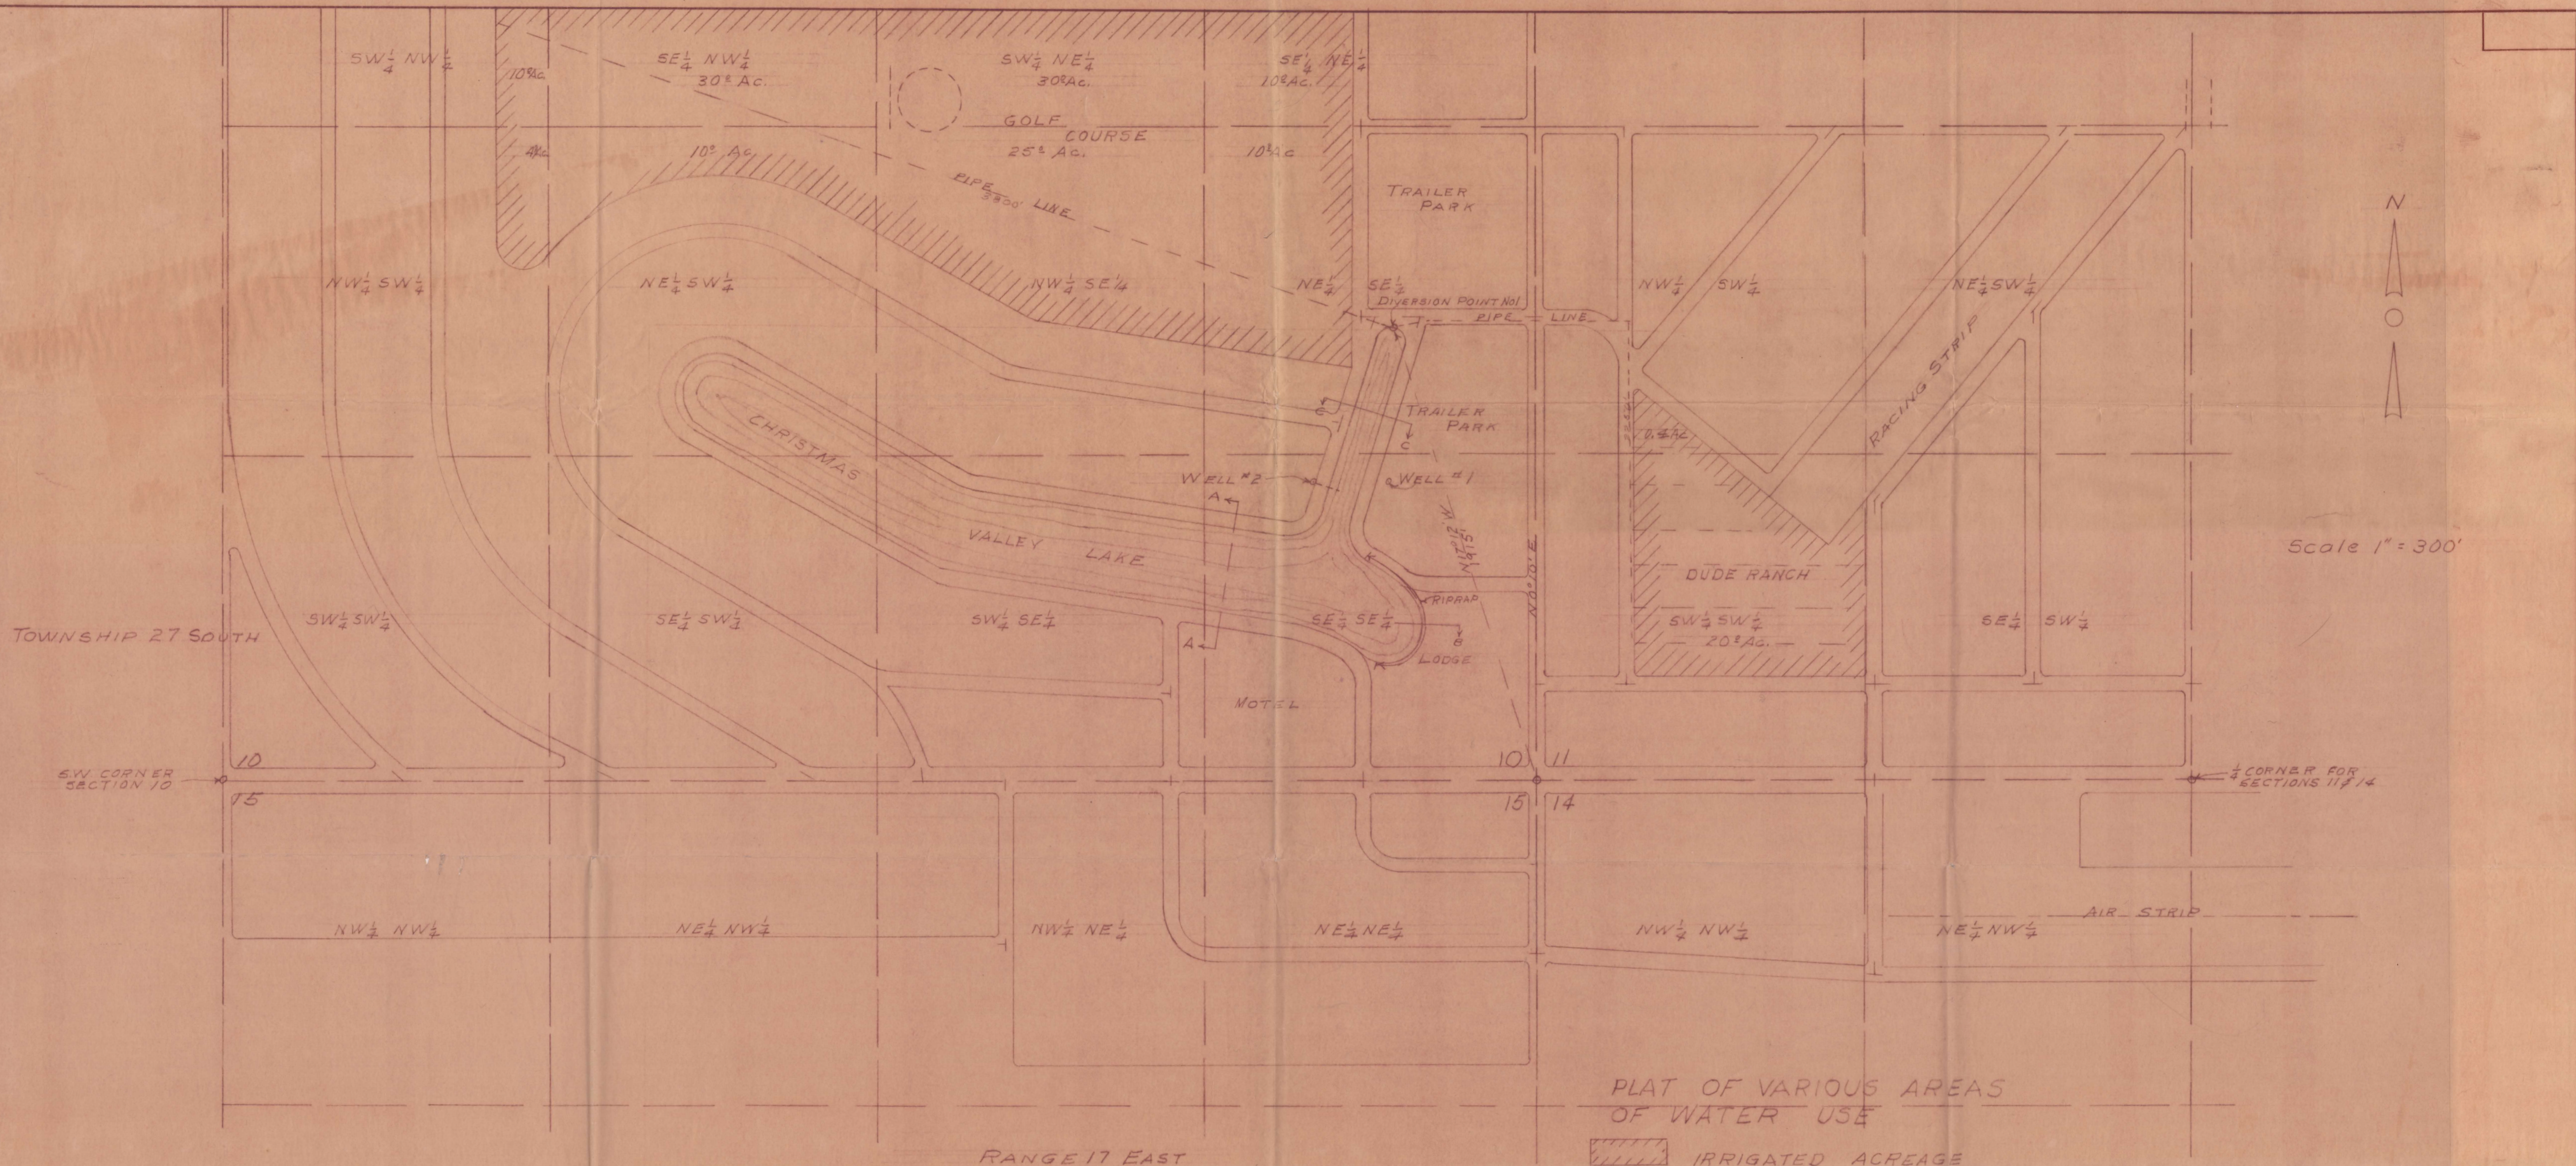

N  
 Scale 1" = 300'


PLAT OF VARIOUS AREAS OF WATER USE

- IRRIGATED ACREAGE
- RECREATIONAL ACREAGE
- DOMESTIC USE

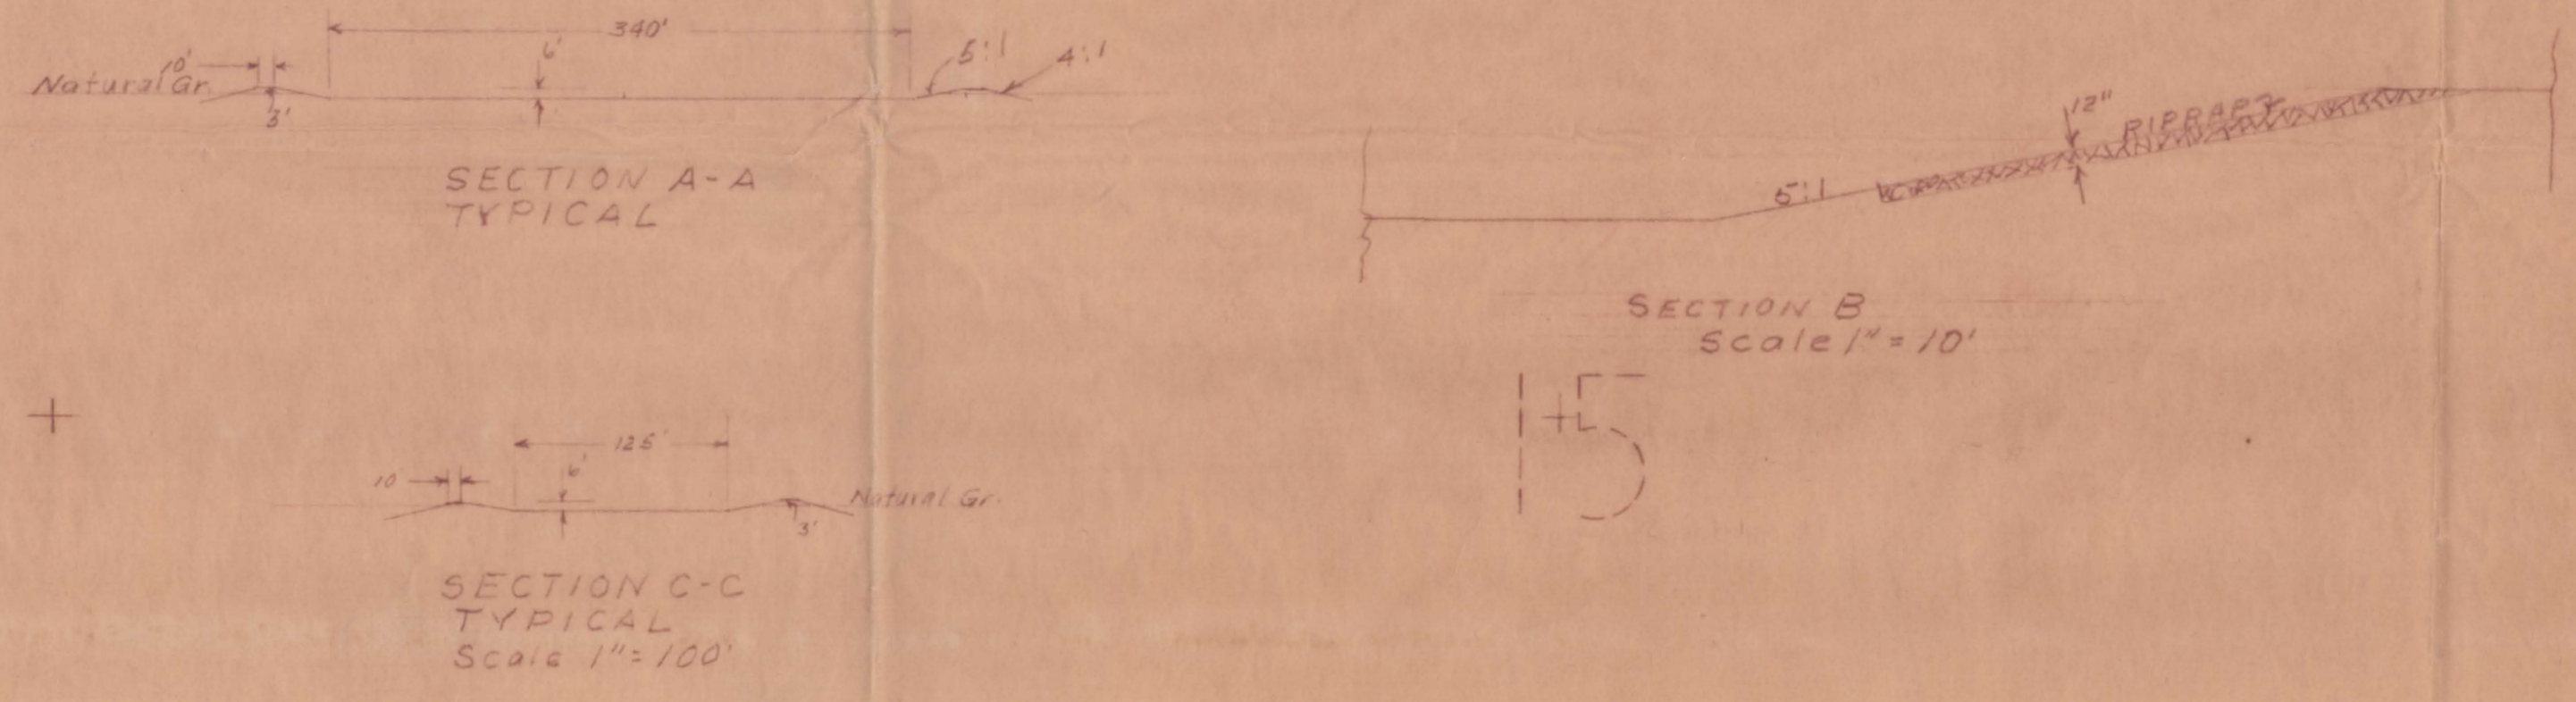


Application No. G-2114  
 Permit No. G-1960

RECEIVED  
 NOV 7 1961  
 STATE ENGINEER  
 SALEM, OREGON

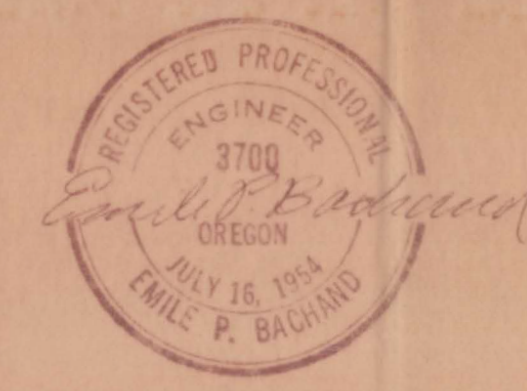


M. FENN PHILLIPS CO AZUSA, CALIFORNIA REAL ESTATE - BUILDERS - LAND DEVELOPMENT	
SCALE: 1" = 300'	APPROVED BY
DATE: 8-18-61	DRAWN BY: DEW
5 1/2 SEC. 10, SW 1/4 SEC. 11, NW 1/4 SEC. 14, & N 1/2 SEC. 15 T27S, R17E W.M.	
EMILE P. BACHAND CONSULTING ENGINEER PRINEVILLE, OREGON	PHONE HI 2-7851
DRAWING NUMBER 11	

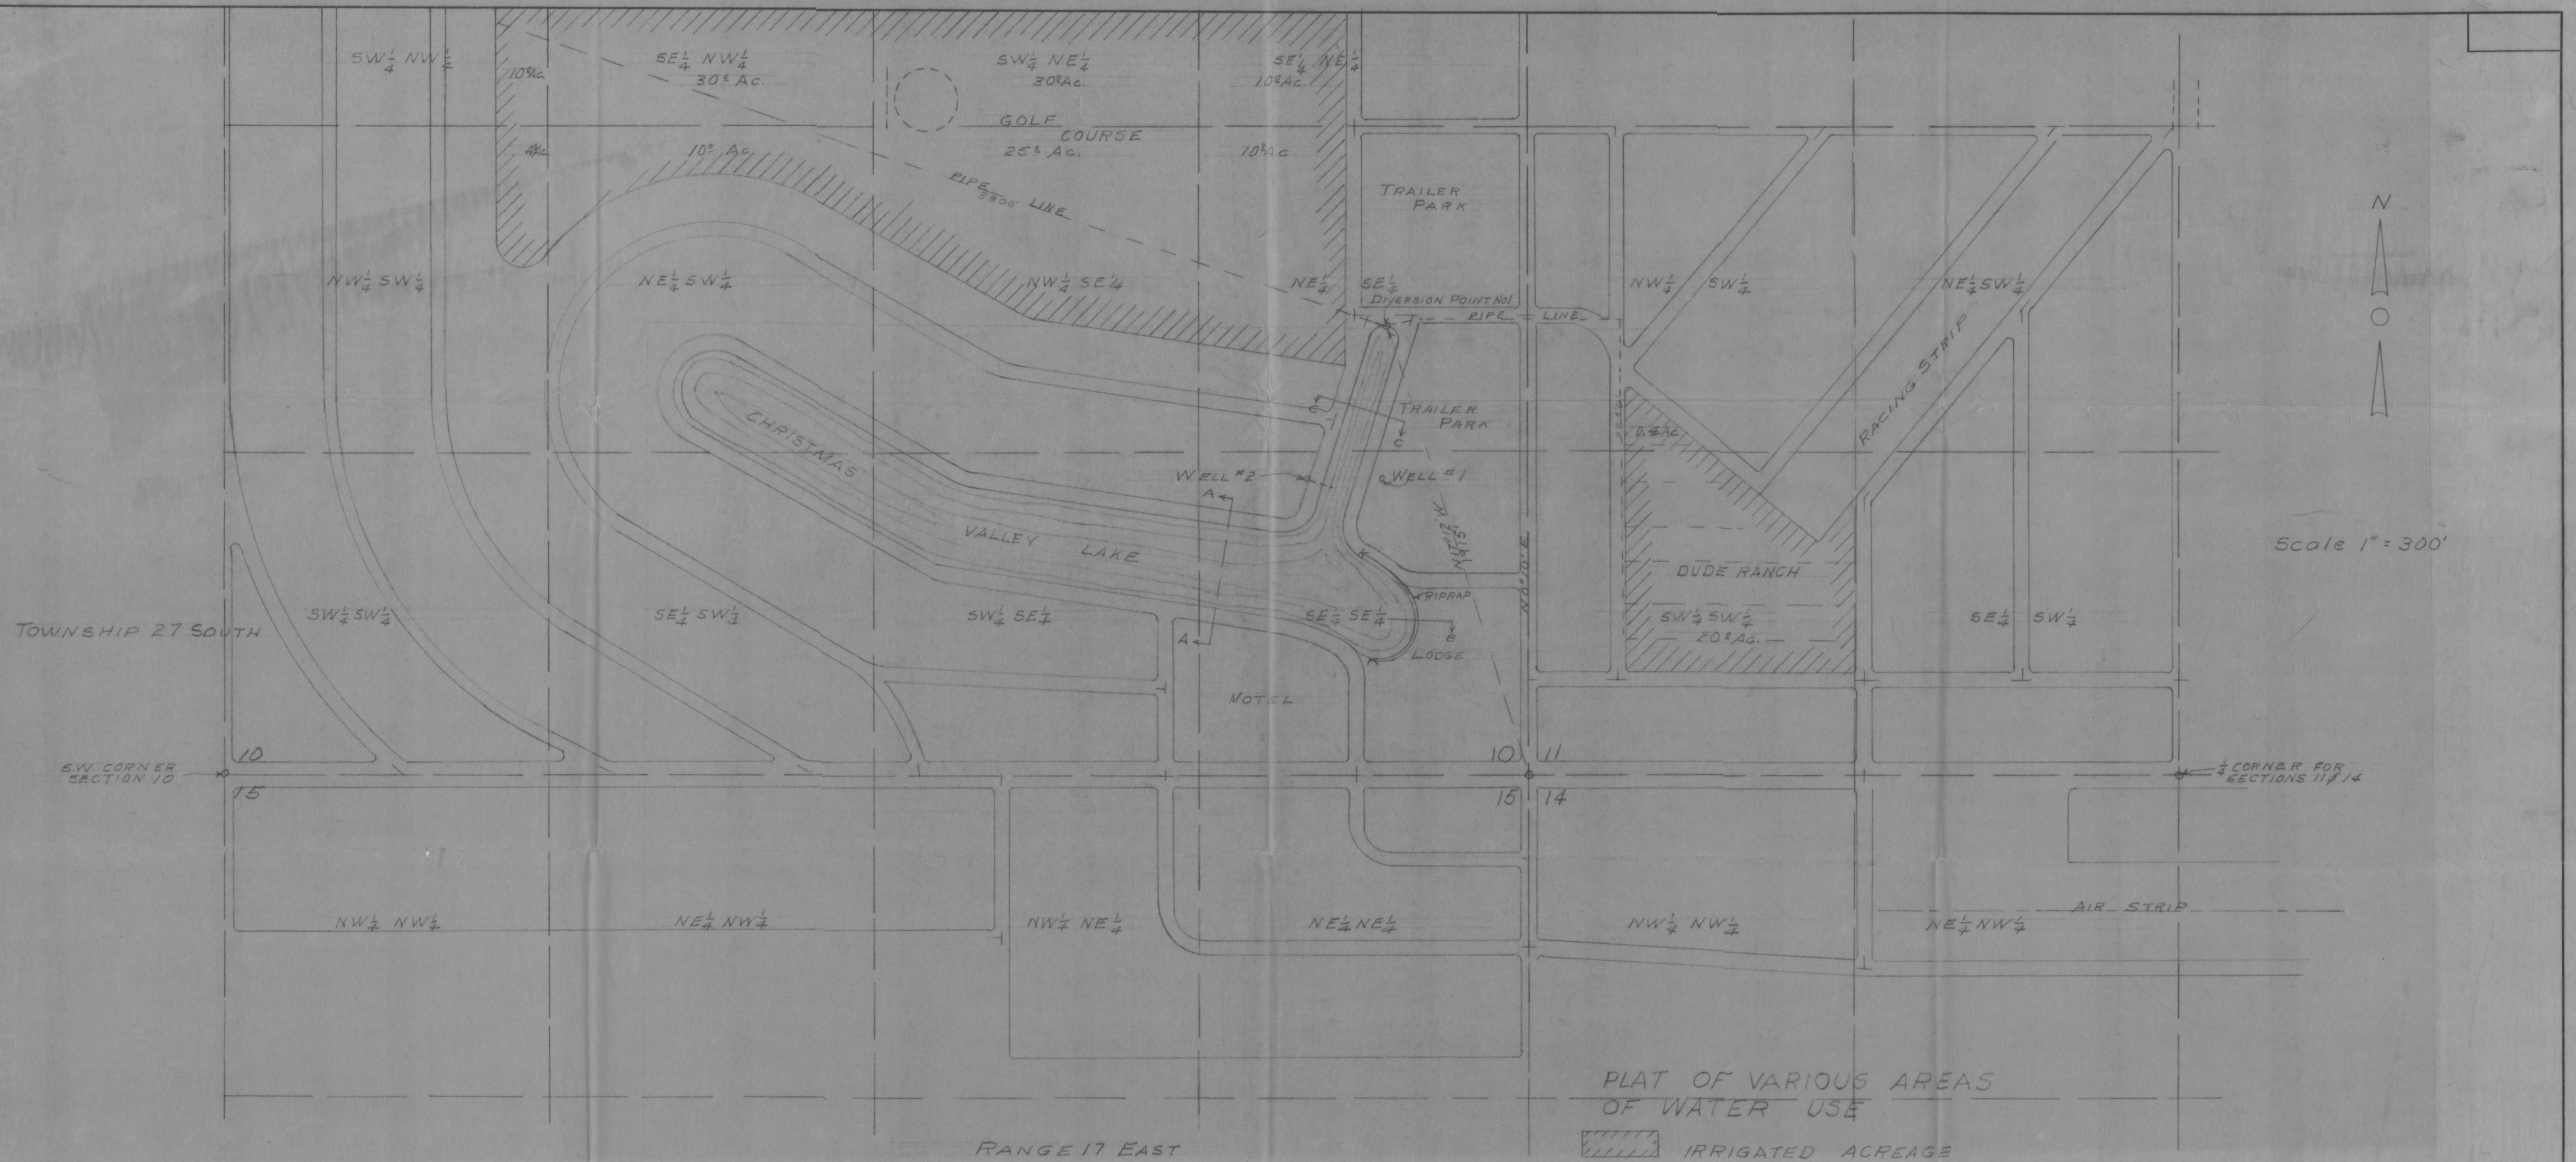

N  
 Scale 1" = 300'


PLAT OF VARIOUS AREAS OF WATER USE

- IRRIGATED ACREAGE
- RECREATIONAL ACREAGE
- DOMESTIC USE

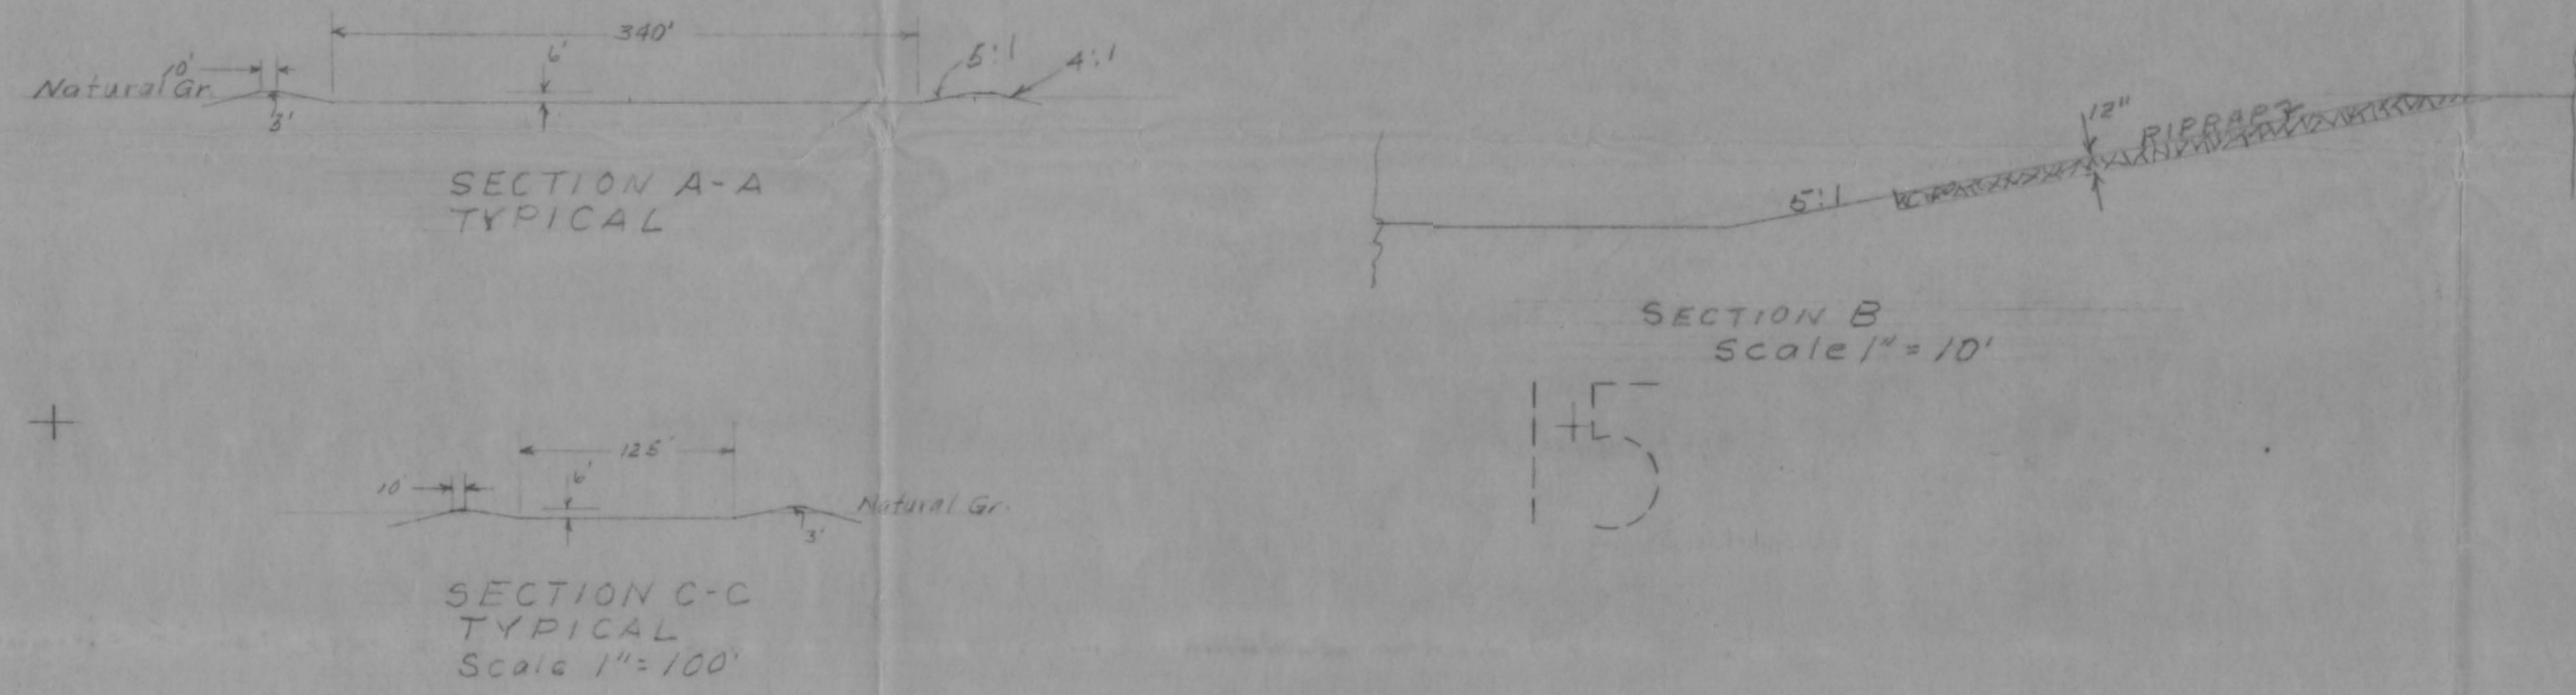

Application No. G-2114  
 Permit No. G-1960

RECEIVED  
 NOV 7 1961  
 STATE ENGINEER  
 SALEM, OREGON

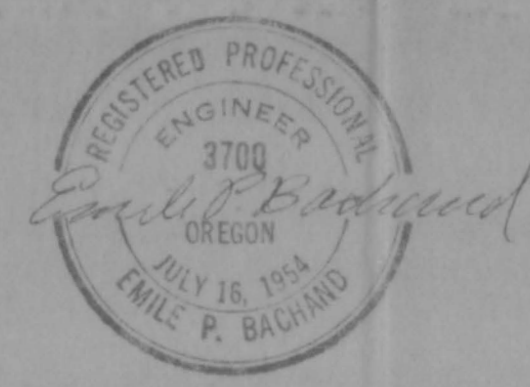

M. FENN PHILLIPS CO AZUSA, CALIFORNIA REAL ESTATE - BUILDERS - LAND DEVELOPMENT		
SCALE: 1" = 300'	APPROVED BY	DRAWN BY DEW
DATE: 8-15-61		TRACED - EPB
5 1/2 Sec 10, SW 1/4 Sec 11, NW 1/4 Sec 14, & N 1/2 Sec 15 T27S, R17E W.M.		
EMILE P. BACHAND PRINVILLE, OREGON	CONSULTING ENGINEER PHONE HI 72681	DRAWING NUMBER 11


T.27S.R.17E.W.M.

FINAL PROOF SURVEY  
UNDER

APPLICATION NO. 21173 PERMIT NO. 2864  
IN NAME OF

M. PENN PHILLIPS COMPANY

SURVEYED BY J. M. ... 1964 BY J. M. ...

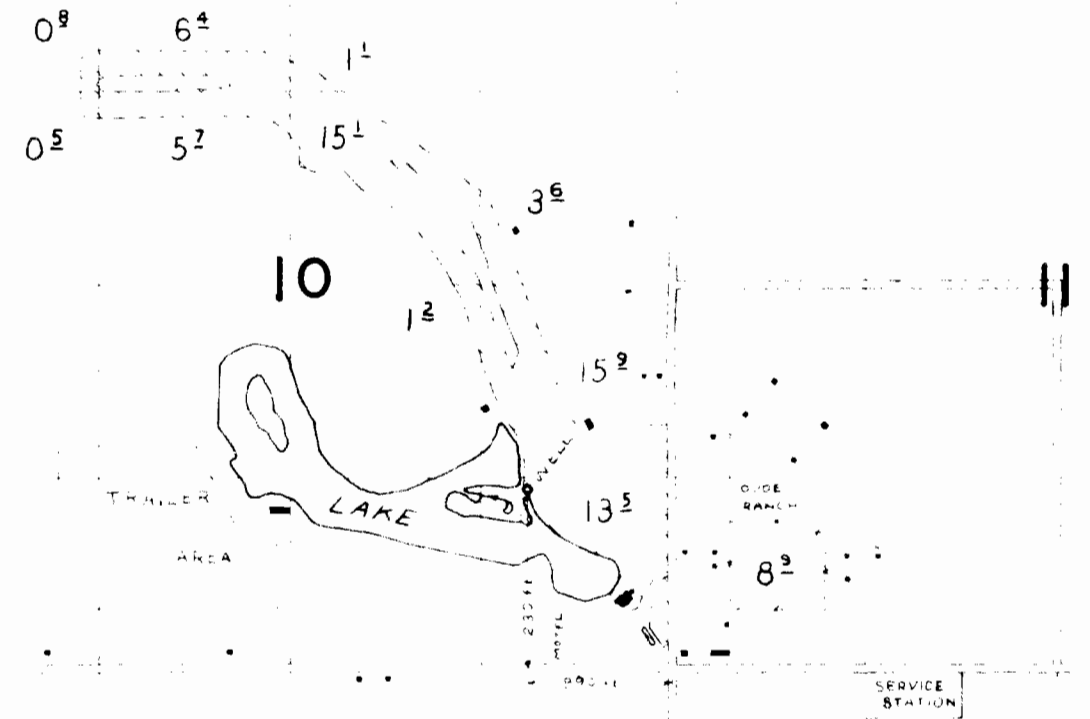

18

17

16

15

14

13

T.27S.R.17E.W.M.

FINAL PROOF SURVEY  
UNDER

APPLICATION NO. G-2114 PERMIT NO. G-1950  
R-97073 R-2682

IN NAME OF

M. PENN PHILLIPS COMPANY

SURVEYED SEP 12 1964, BY R. V. GIBSON

