
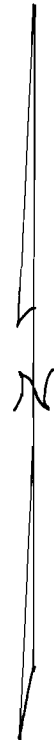


T.16S.R.4W.W.M.

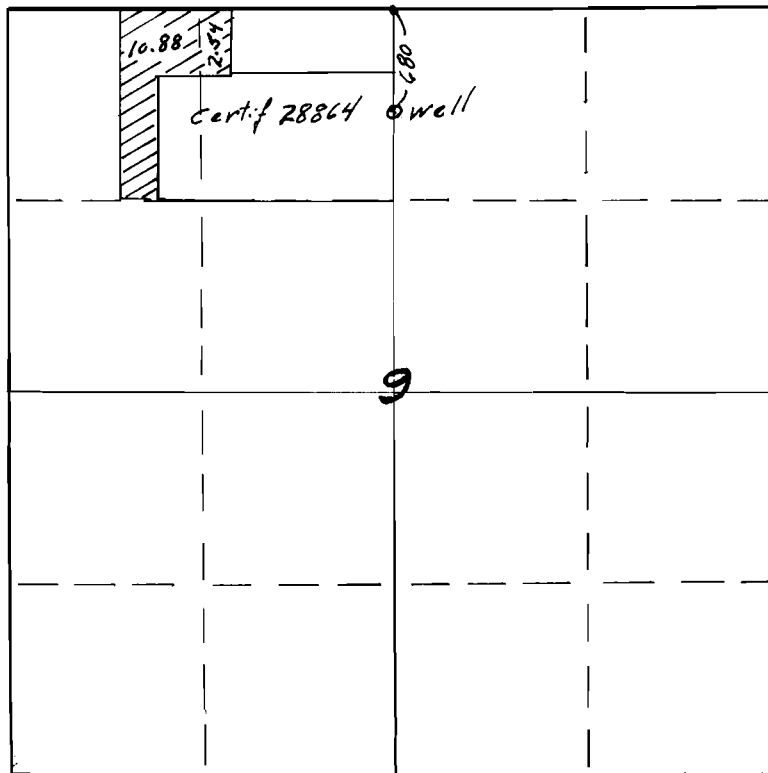

4" = 1 Mile

Application No. G-2130  
Permit No. G-1957