


JUL 19 1984  
WATER RESOURCES DEPT  
EARTH, OCEAN

WWR

# T.6N.R.35&36E.W.M.

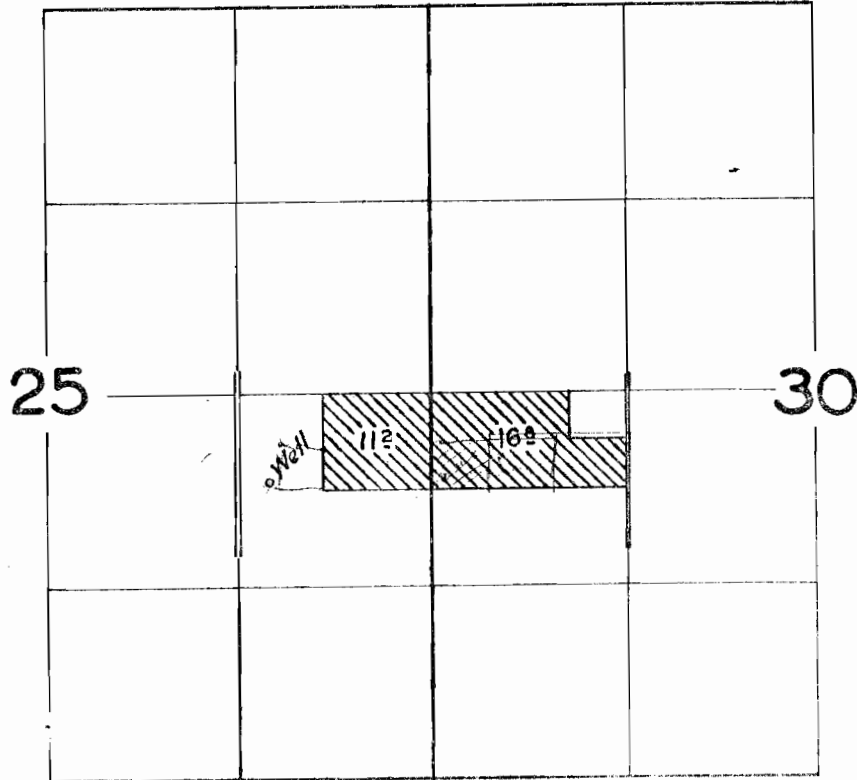

## FINAL PROOF SURVEY UNDER

Application No. **G-2153** Permit No. **G-1991**  
IN NAME OF

**VERNON E. BRUMBACH**

Surveyed *May 3* 1962, by *R. Jackson*