


# PLAT-SHOWING LOCATION OF WELL ON BOISE CASCADE SAWMILL PROPERTY at ELGIN, OREGON

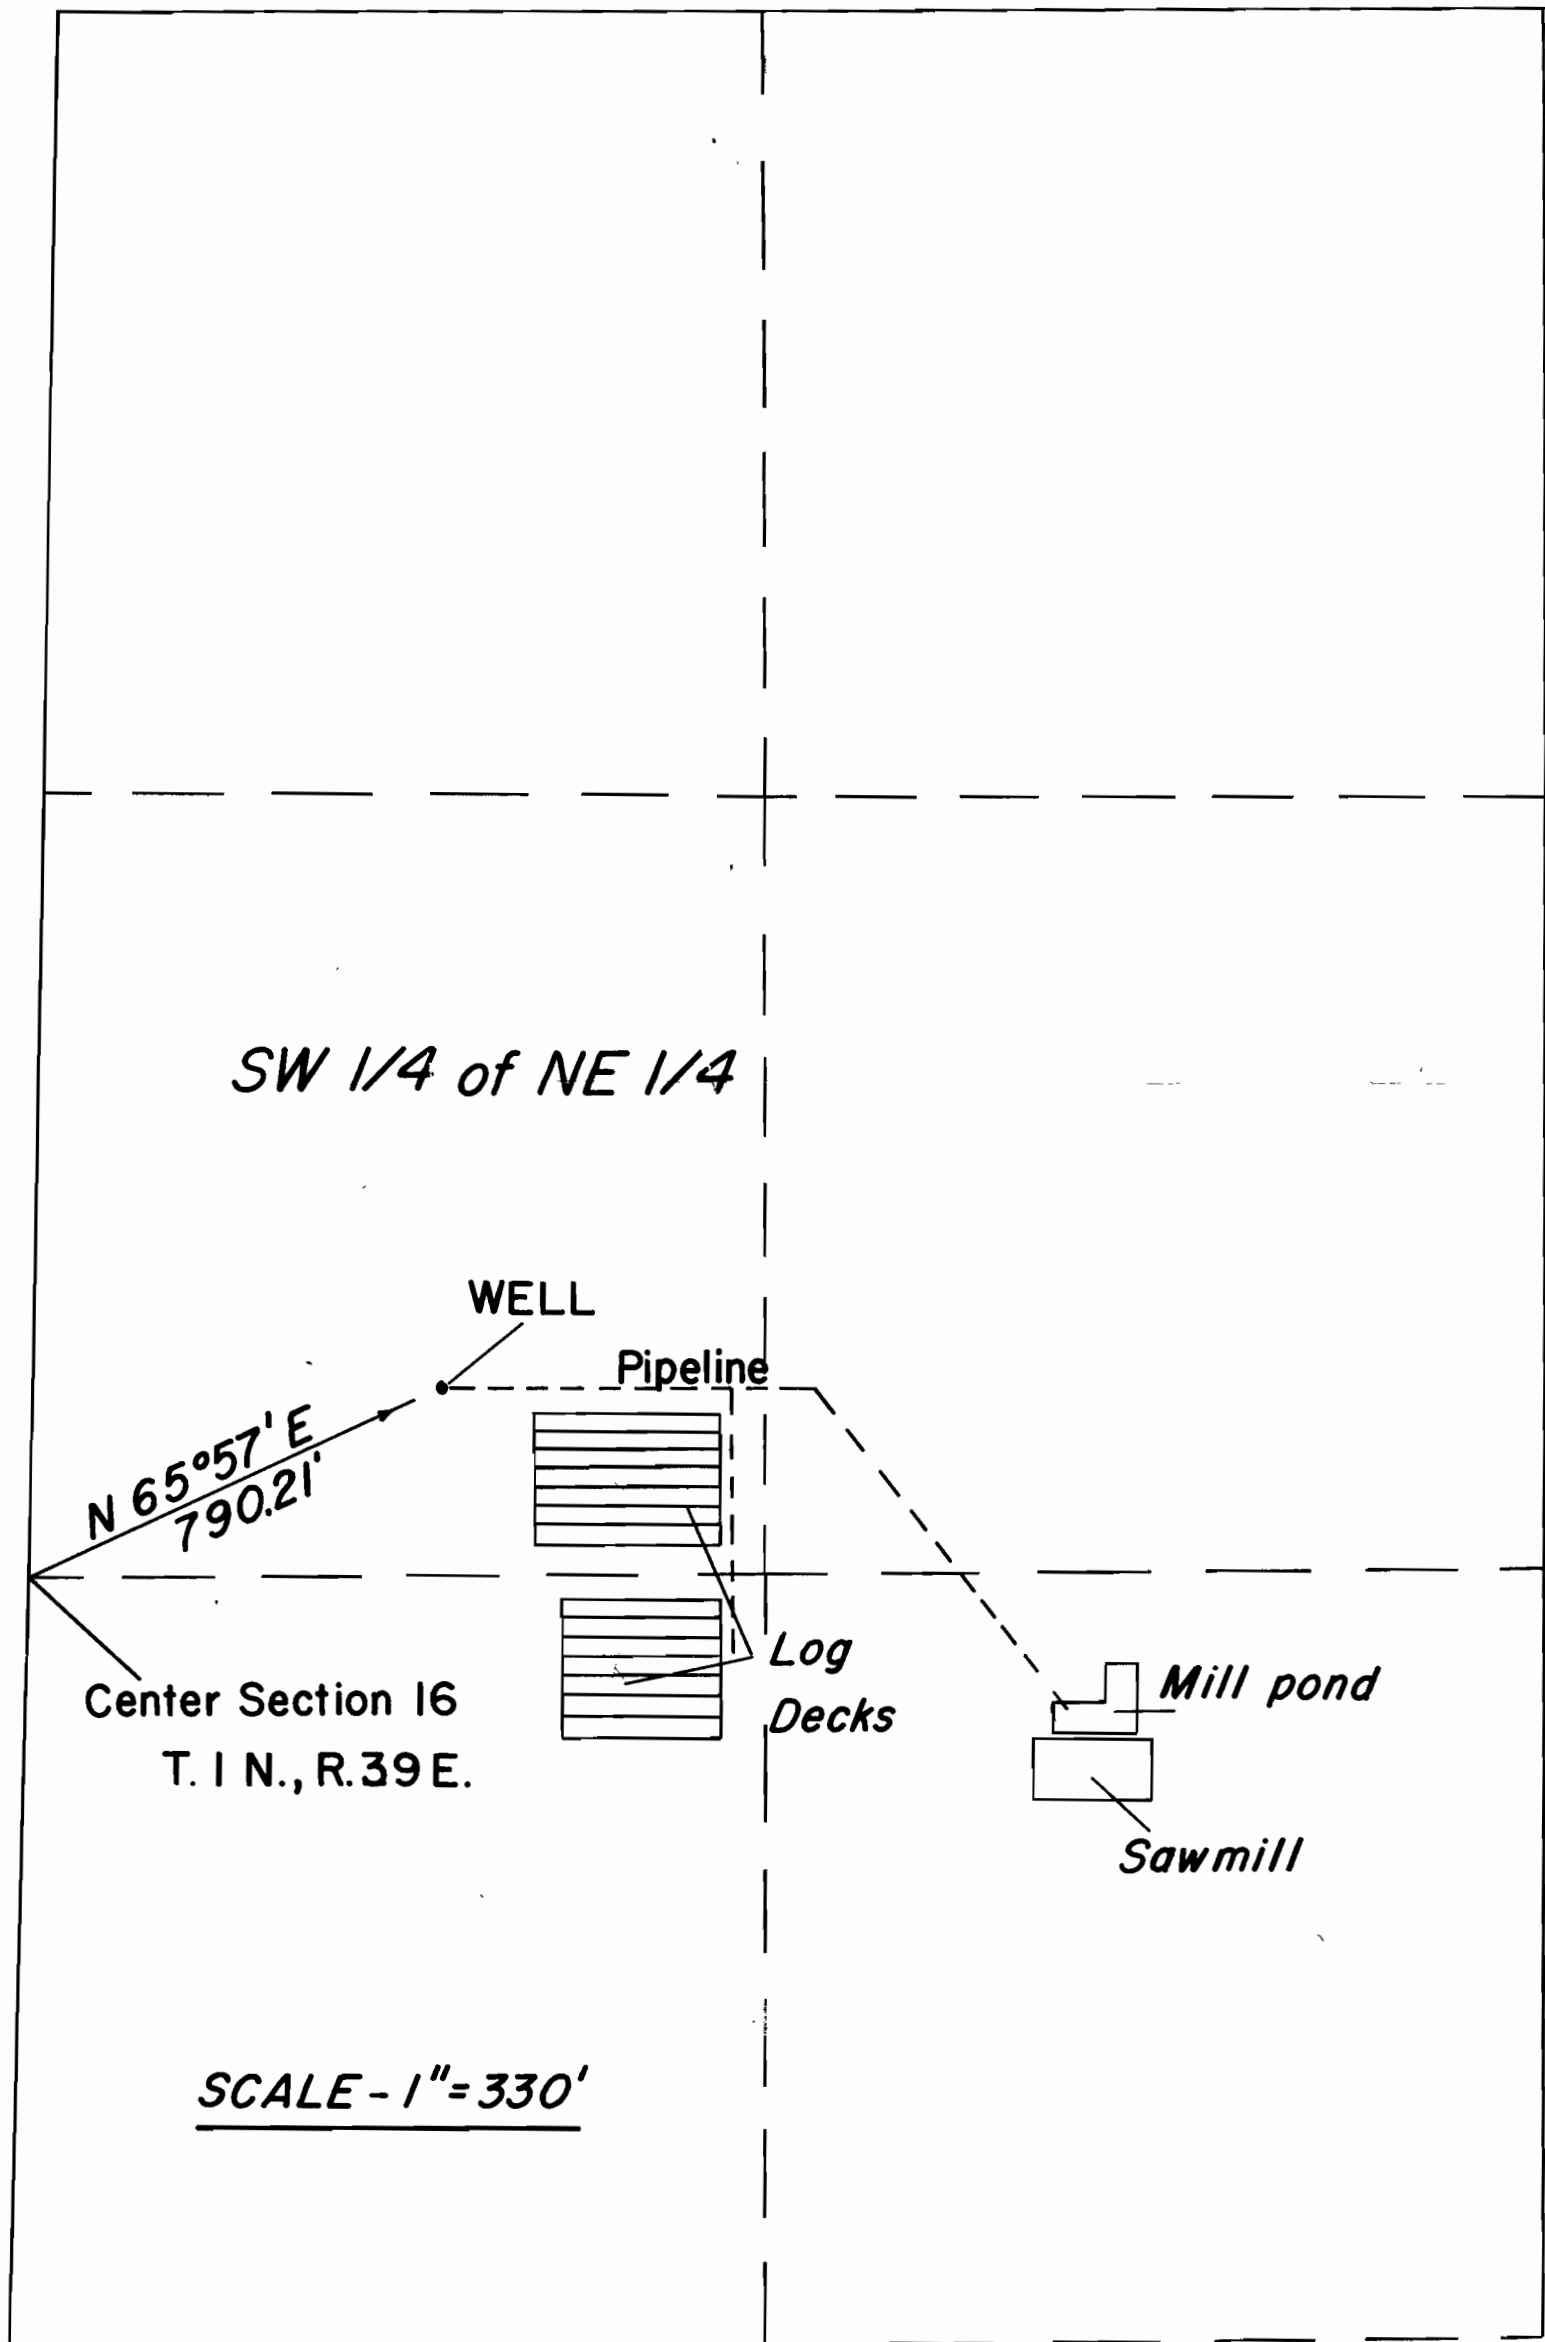

Application No. G-2210  
Permit No. G-2035

DW