







RECEIVED  
FEB 13 1906  
STATE ENGINEER  
SALEM, OREGON

RECEIVED  
FEB 13 1906  
STATE ENGINEER  
SALEM, OREGON


Application No. R-2238  
Permit No. 8-2061

O.B.B.

WILLIAM A. T. A

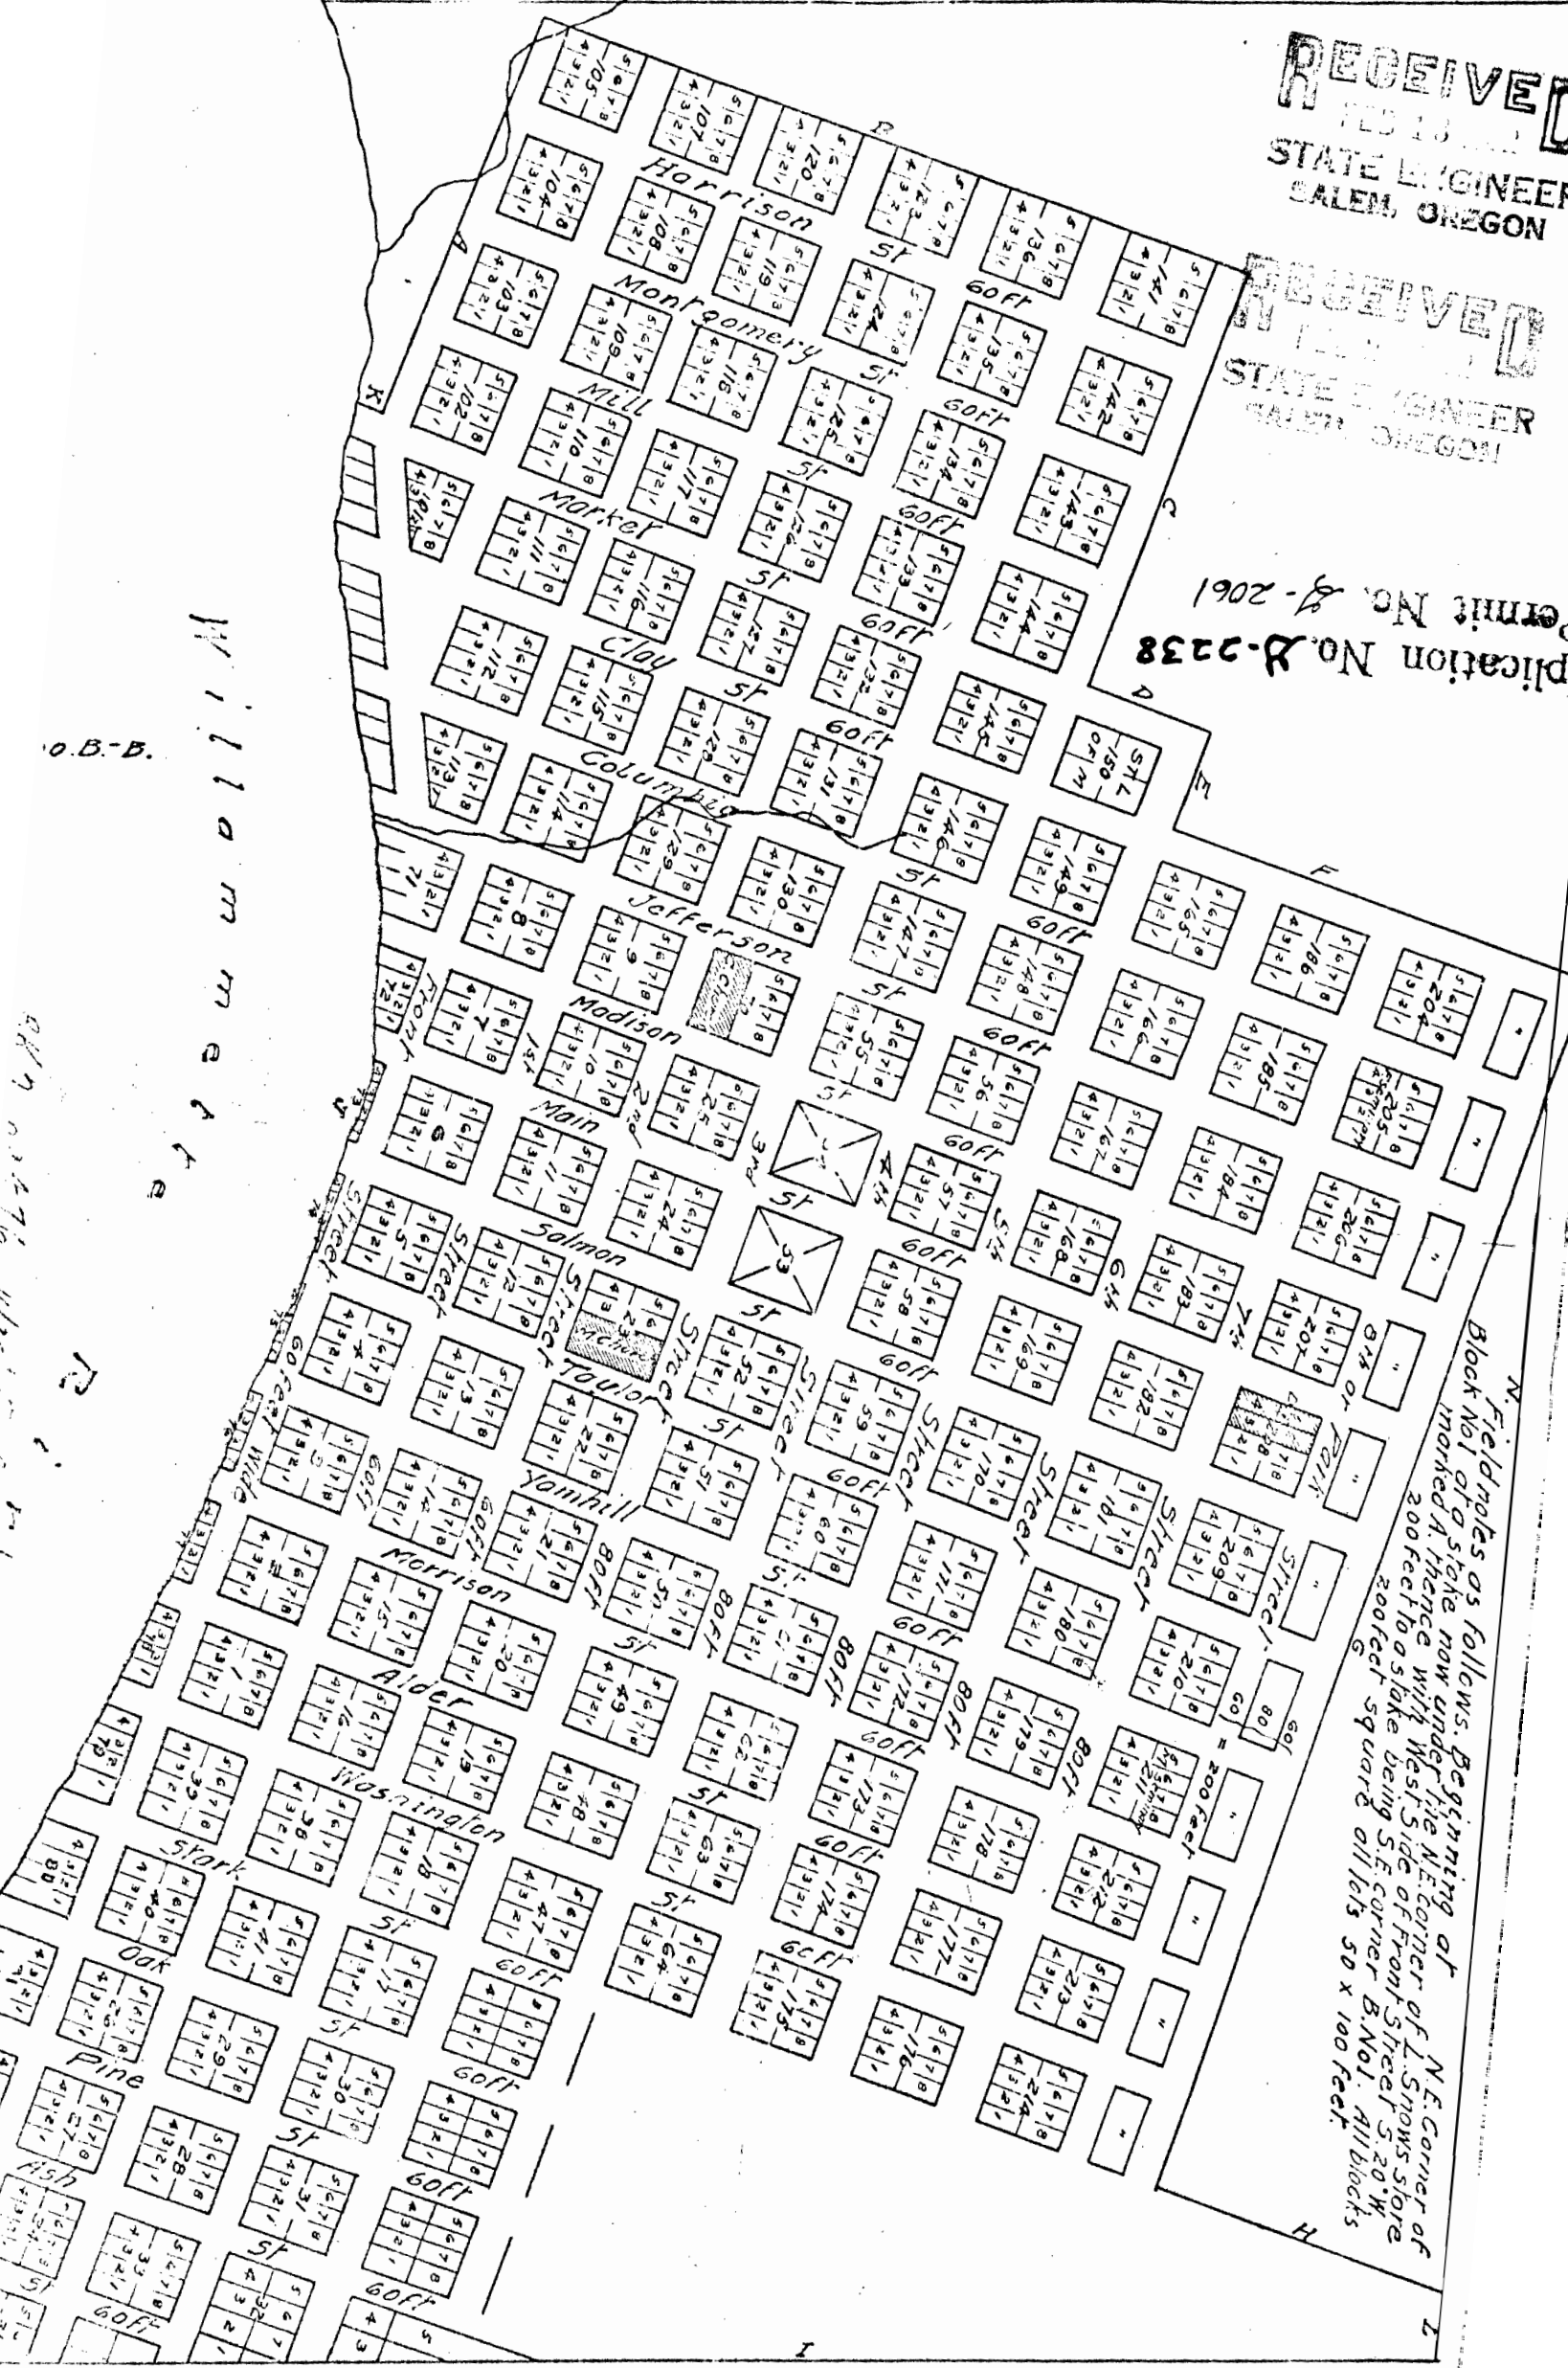

Field notes as follows: Beginning at N.E. corner of L. Snows store marked A thence run under the N.E. corner of L. Snows store 200 feet to a stake being S.E. corner B. No. 1. All blocks 200 feet square all lots 50 x 100 feet.

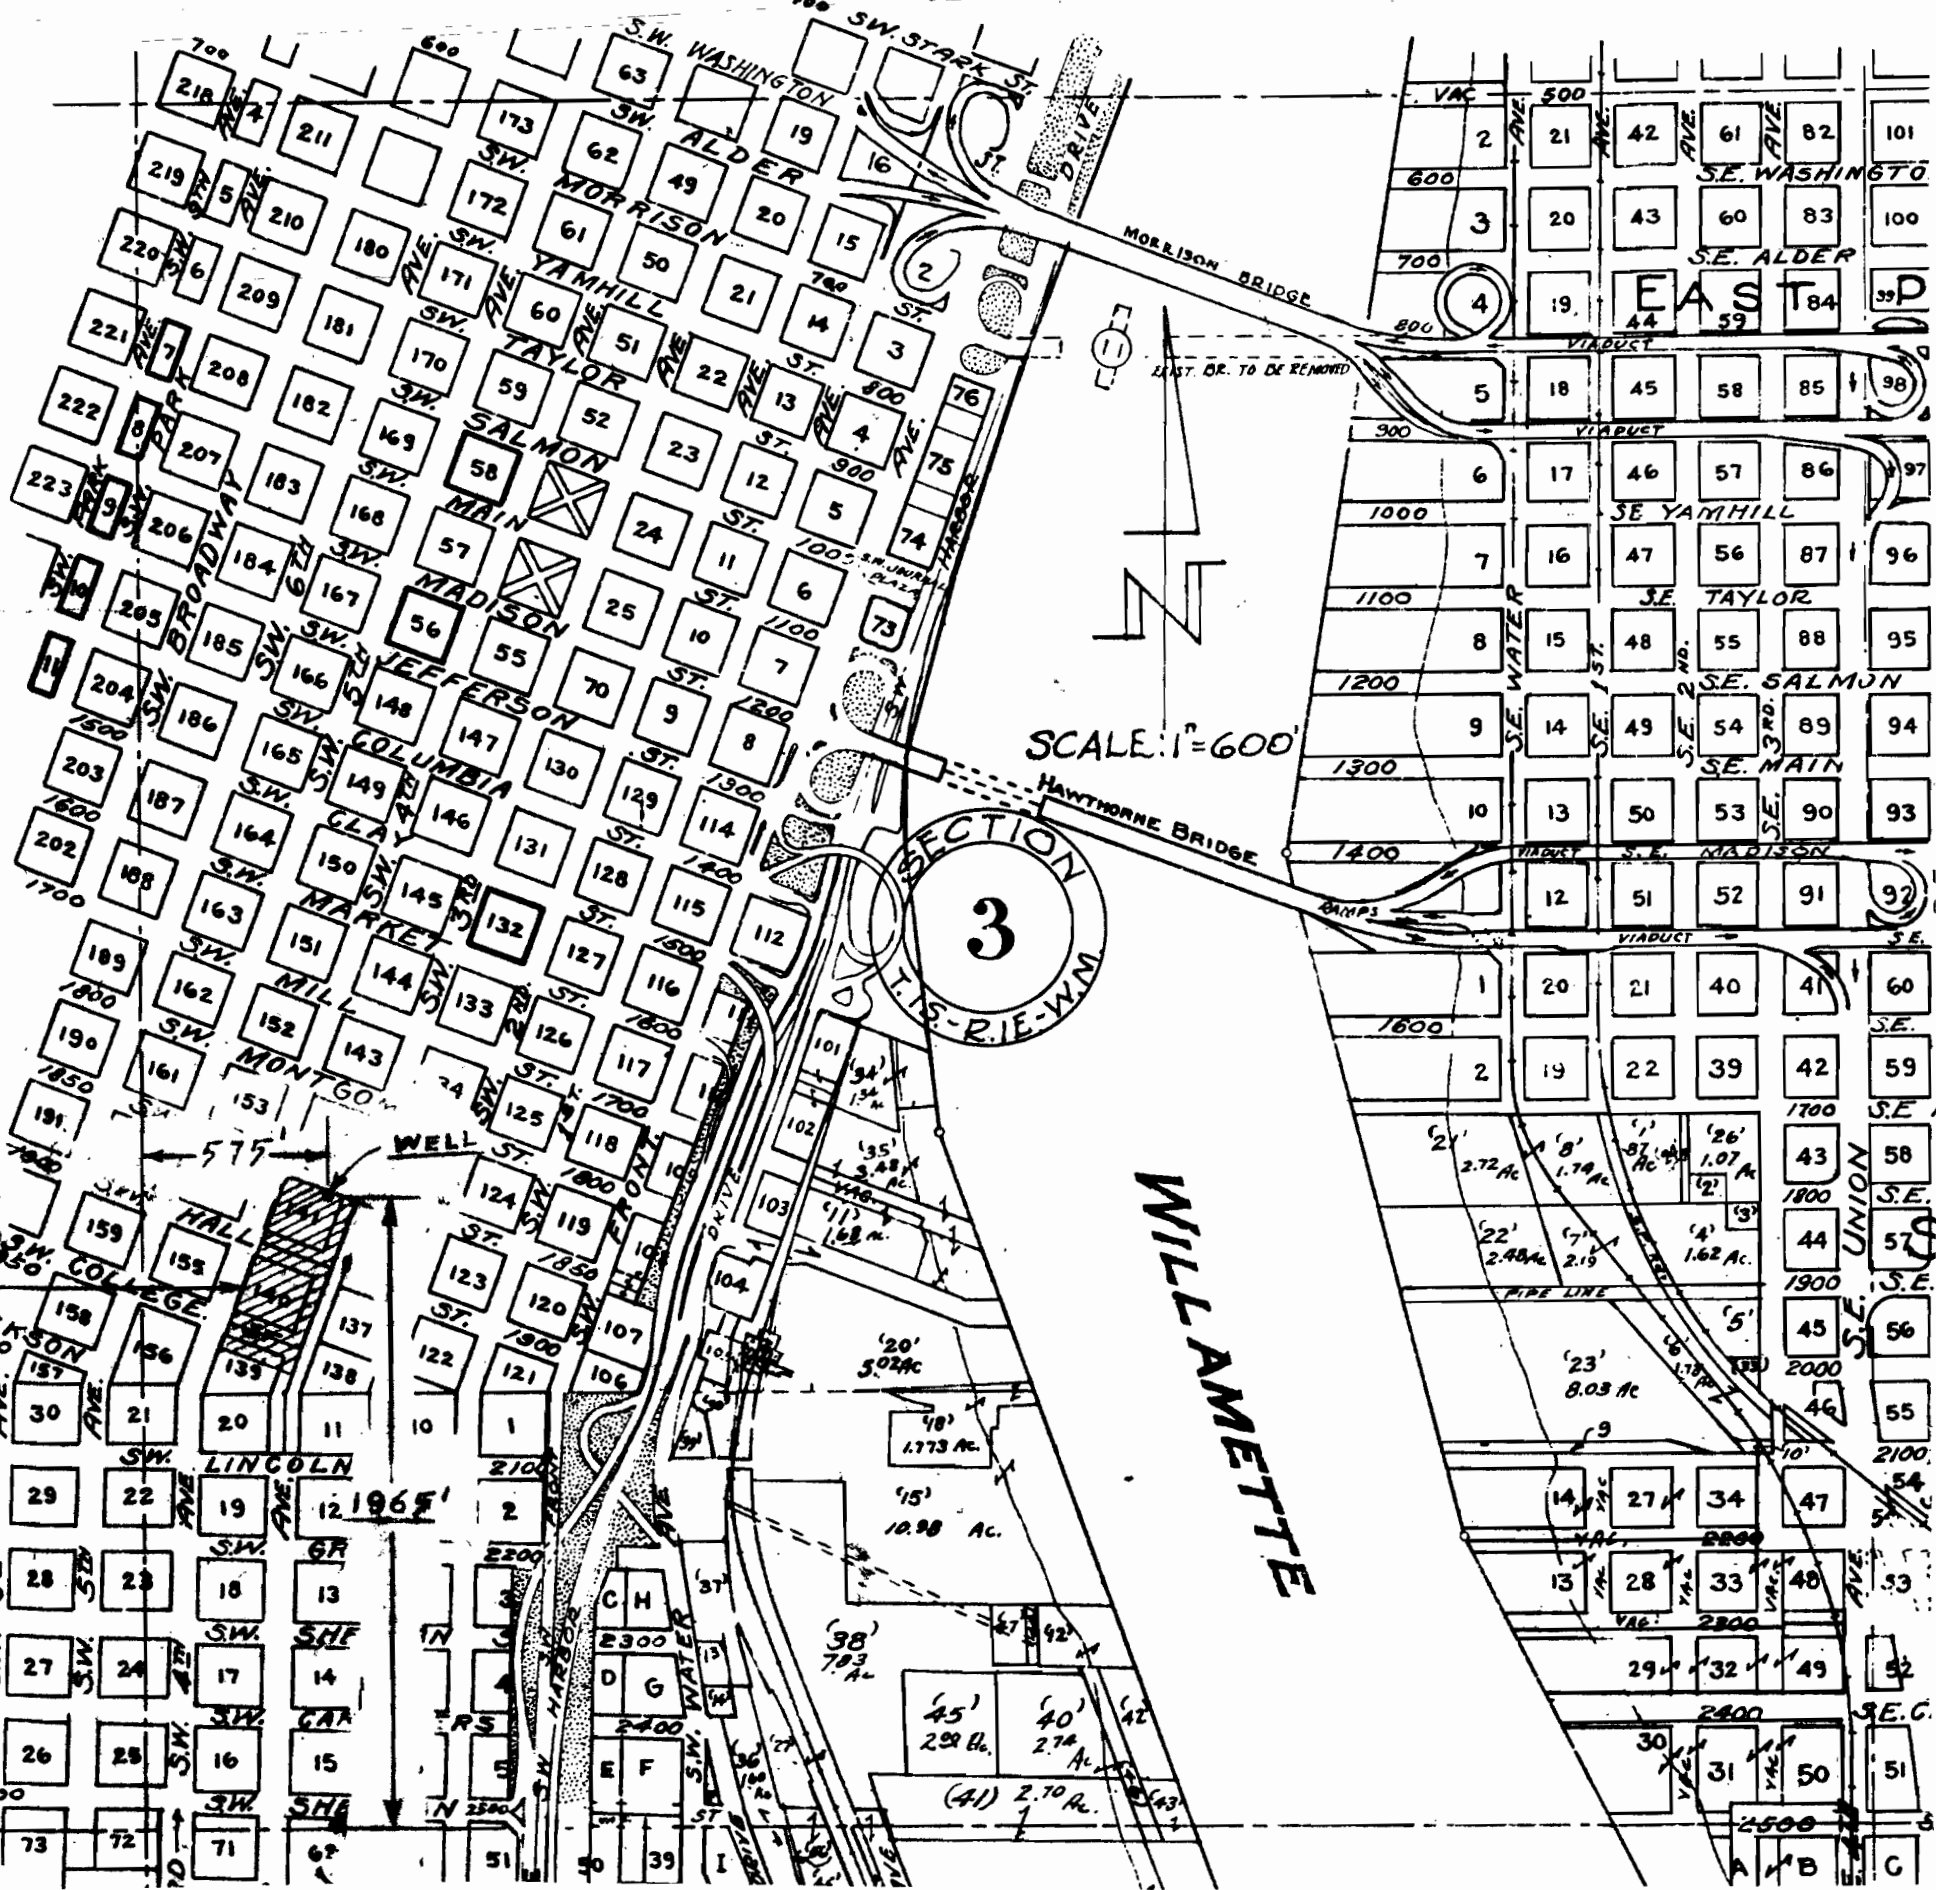

Pacific Northwest  
Bell Telephone Co.  
Property

Application No. G-2238  
Permit No.

20