


LAND of CHARLES E. HOWELL

Sec. 36 Twp 6S - Rng 3W in the Silas Pugh D.L.C.

Scale 1" = 200'

SHOWING LOCATION OF WELL
and Area to be Irrigated

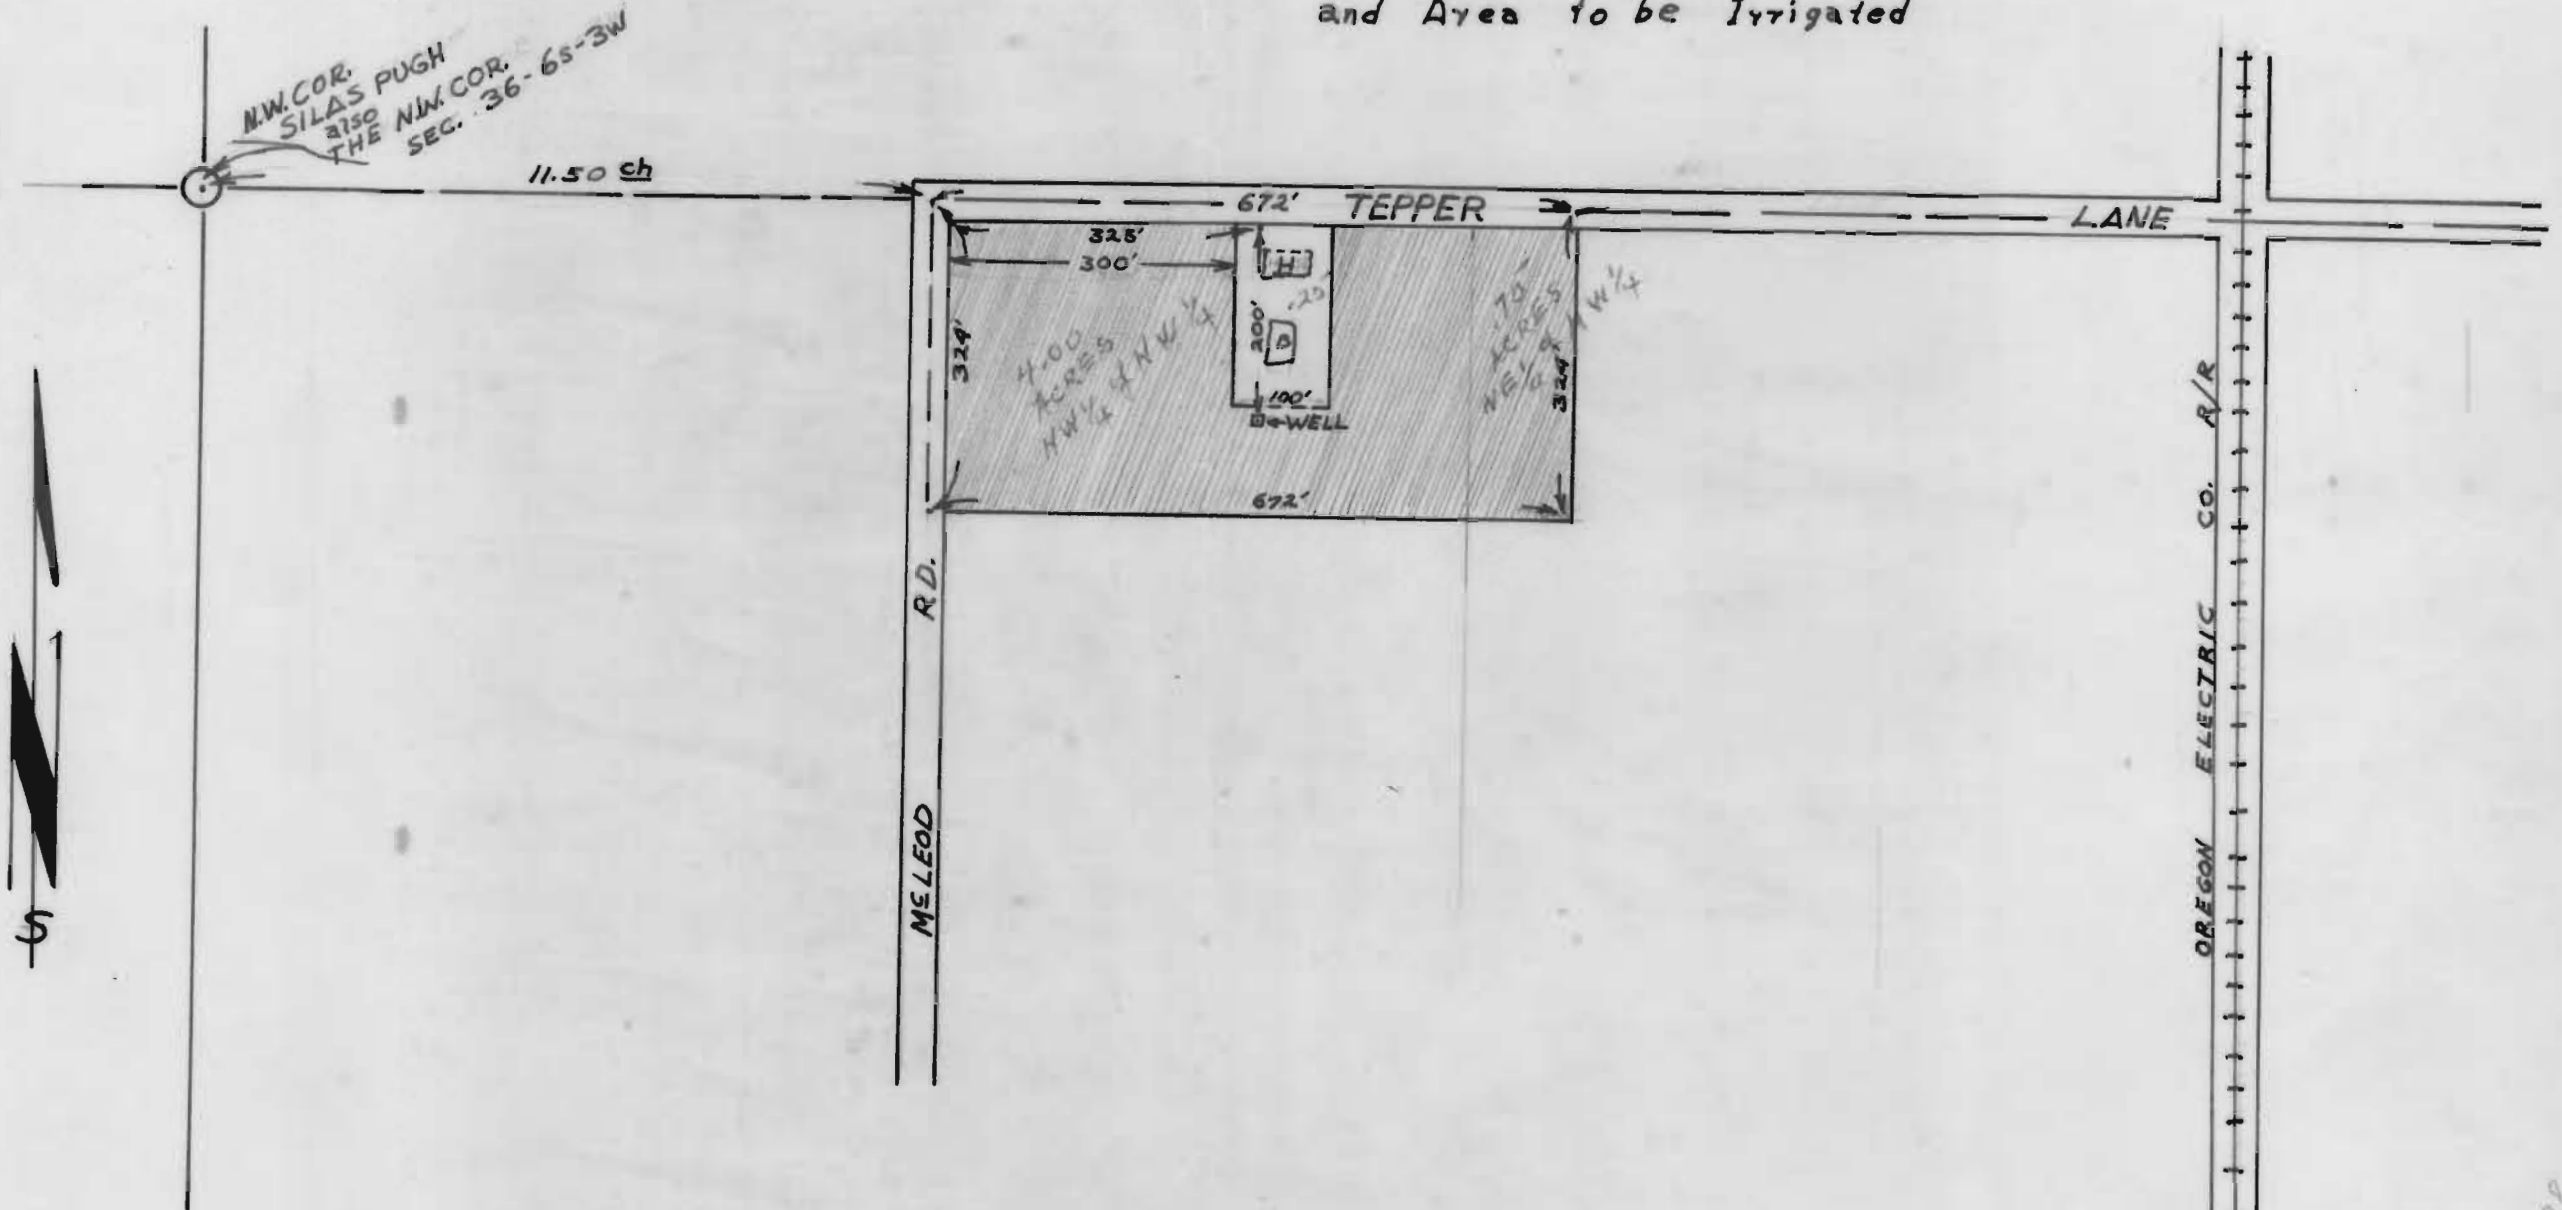

Application No. G-298
Permit No. G-212