


T. 41 S. R. 8 W W M

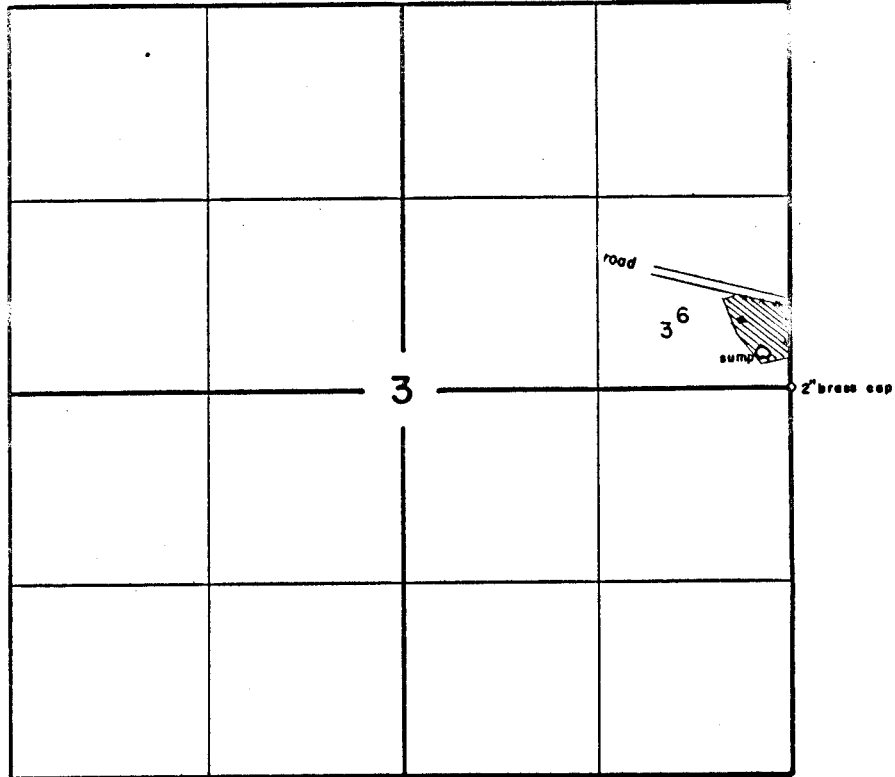

FINAL PROOF SURVEY UNDER

Application No. 3-2301, Permit No. 6-2121
IN NAME OF

.....

Surveyed Feb. 19, 1965, by R. D. STEWART