


T. 37 S., R. 2 W., W.M.

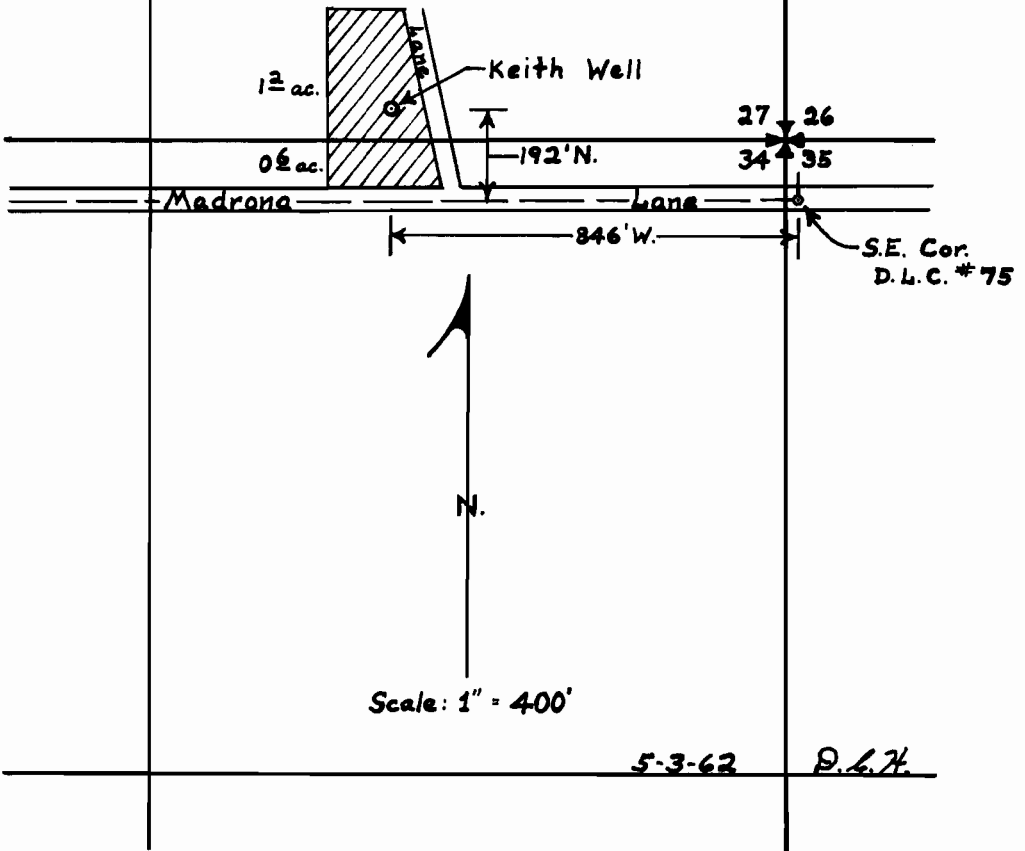

Byron and Marie Keith

Amplified NO. G-2316
G-2147