


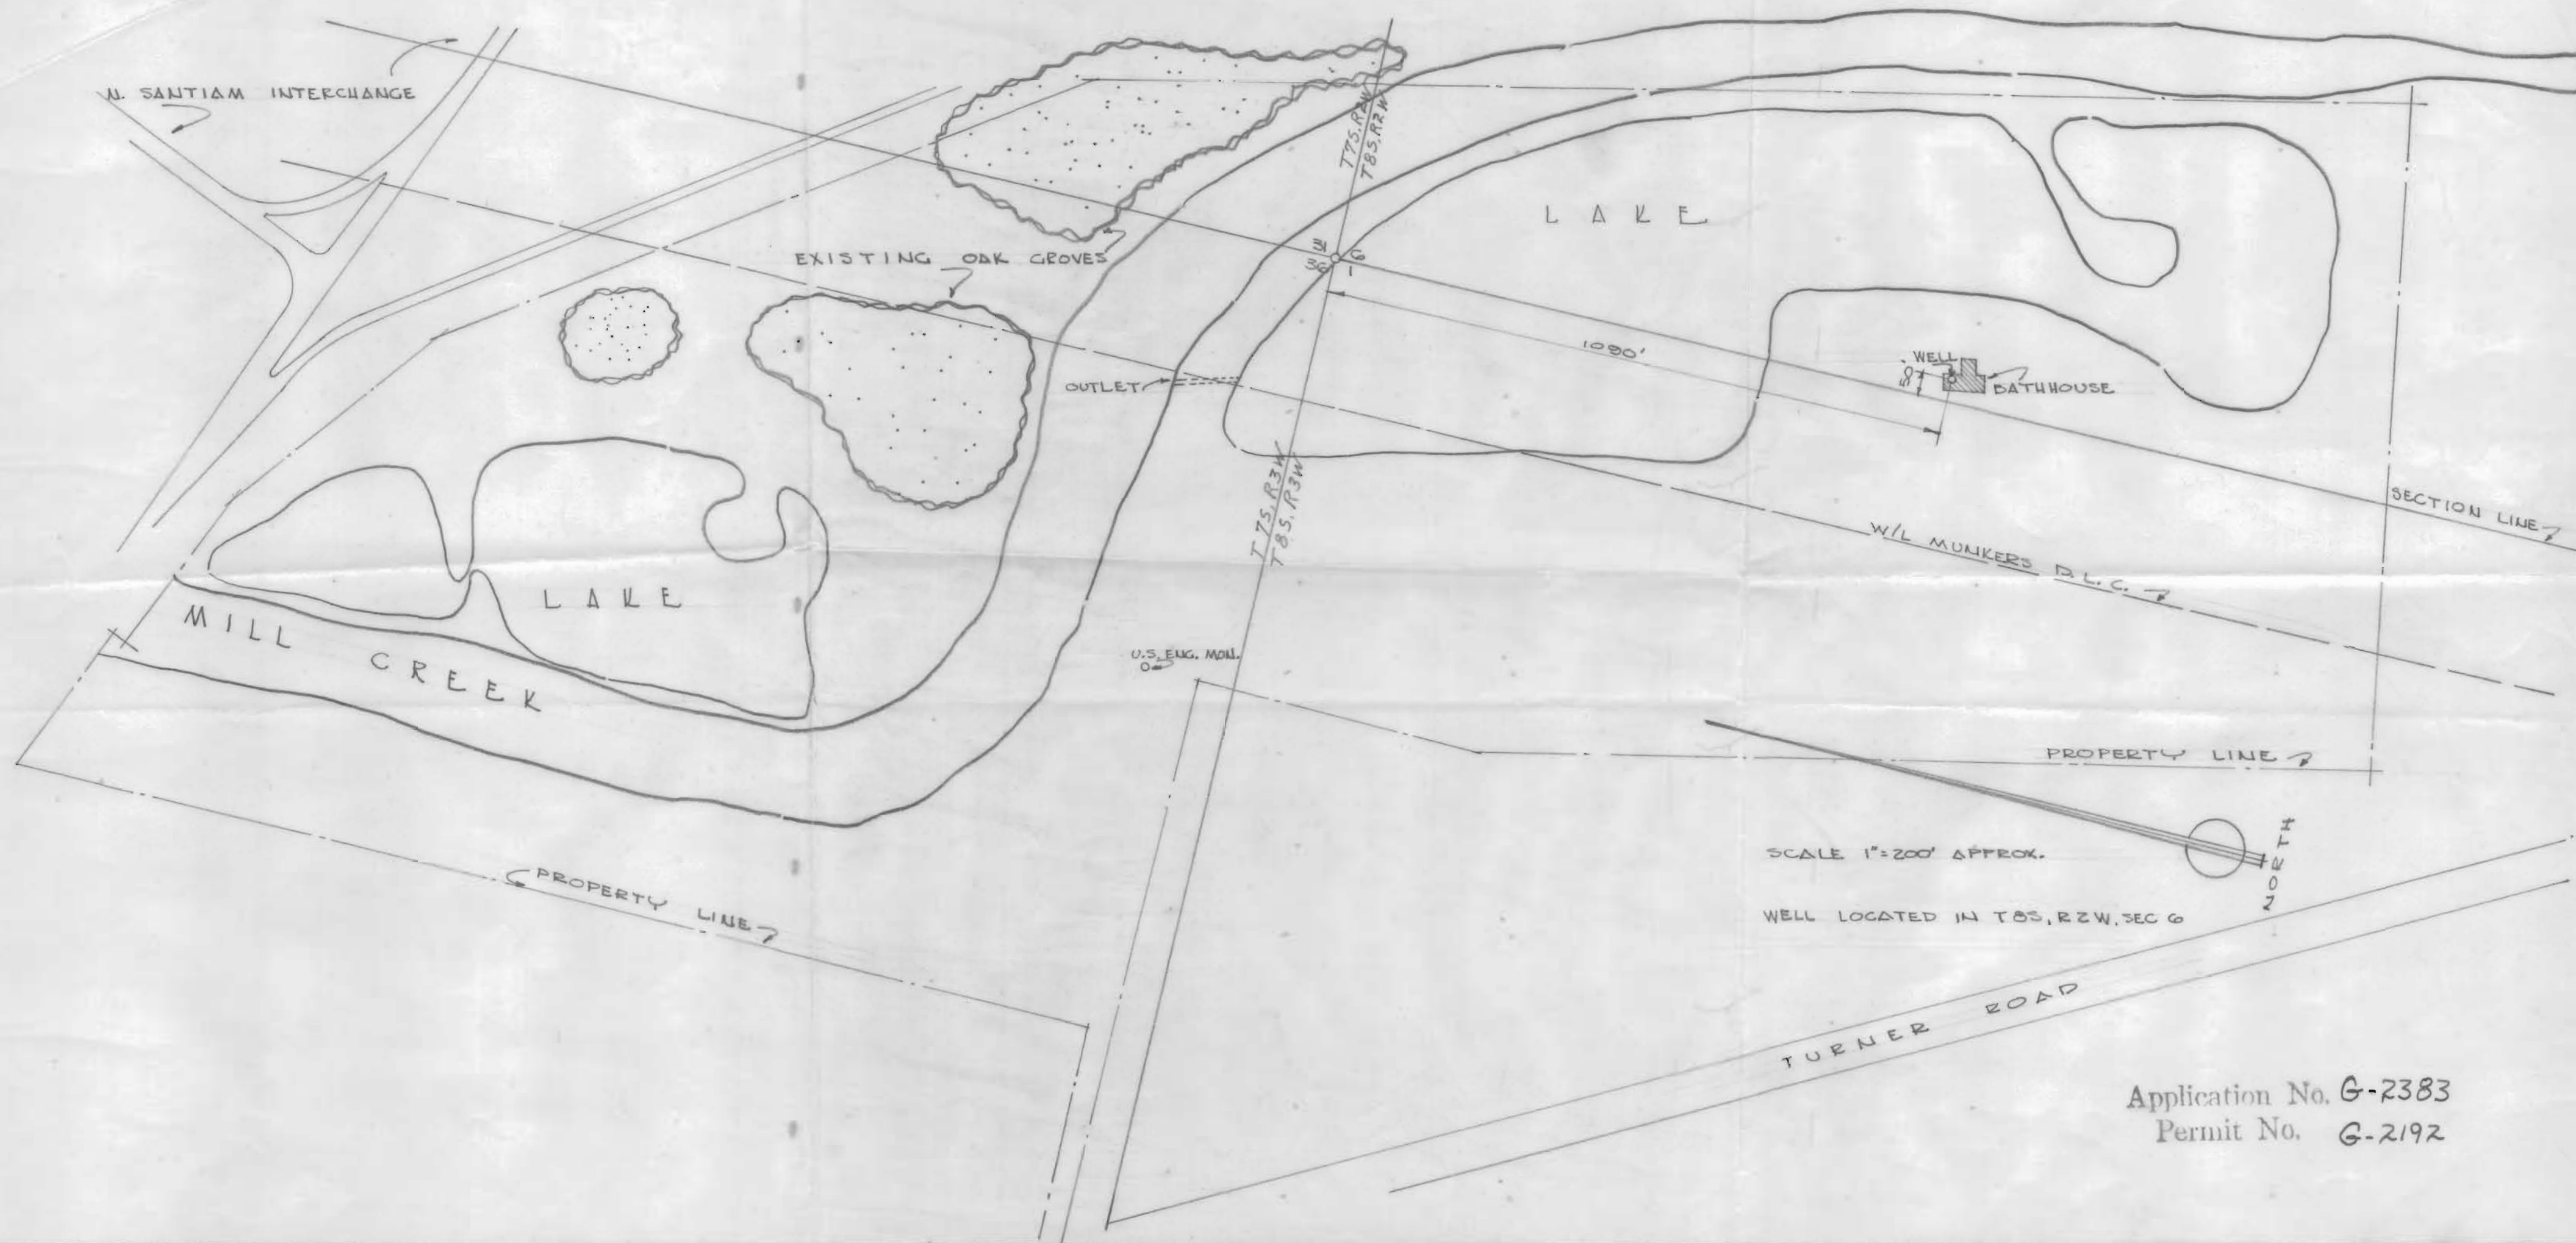

Application No. G-2383
Permit No. G-2192