


T.1 N. R.3 E. W.M.

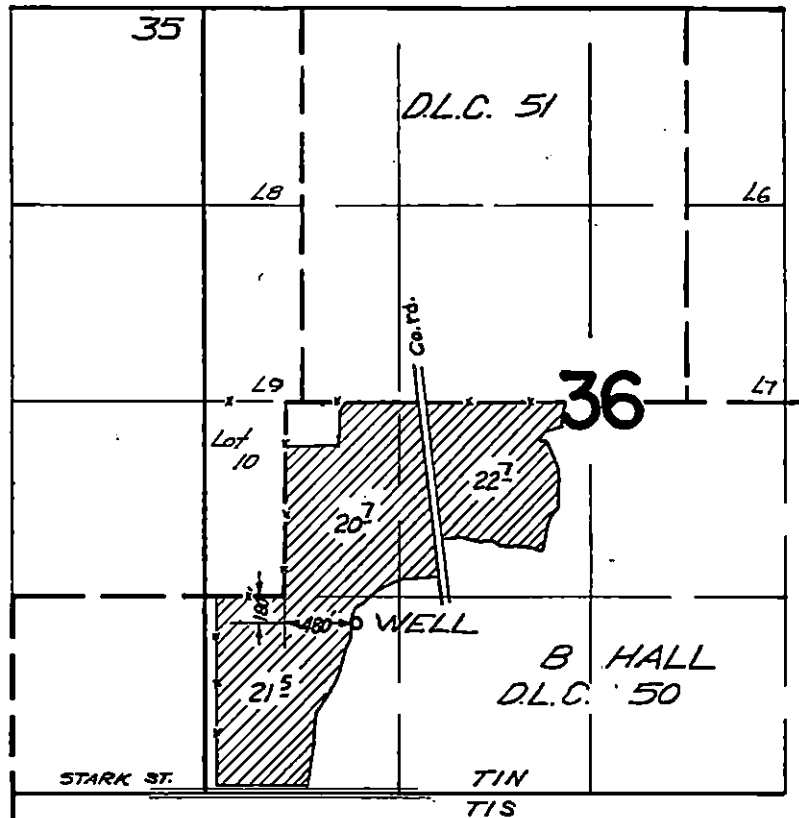

FINAL PROOF SURVEY
UNDER

Application No. G-2512 Permit No. G-2320
IN NAME OF

JAMES M. FUJII

Surveyed Sept. 1, 1966, by V. GARNER