
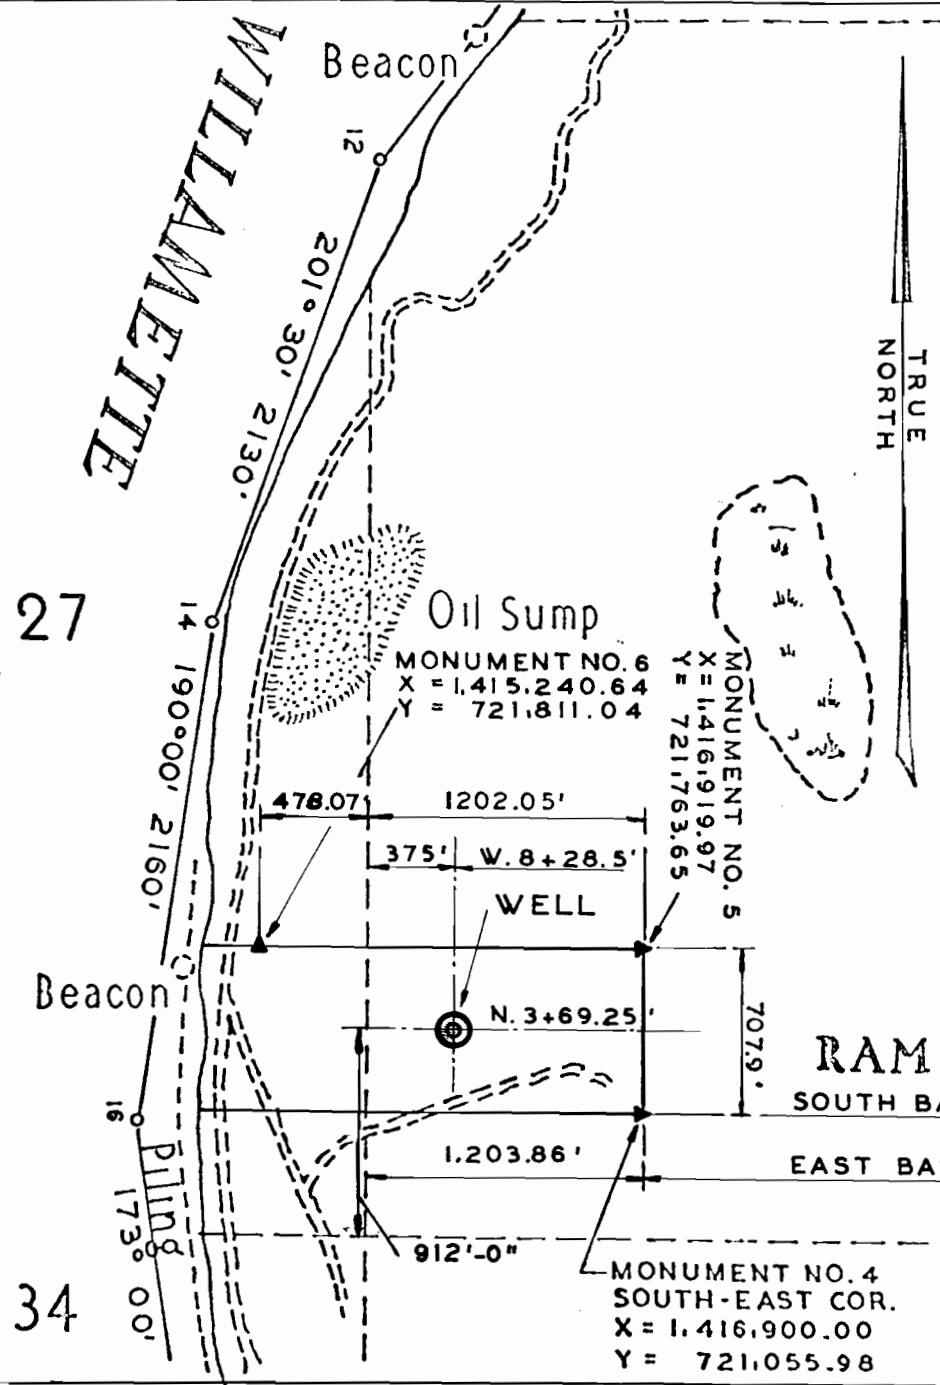
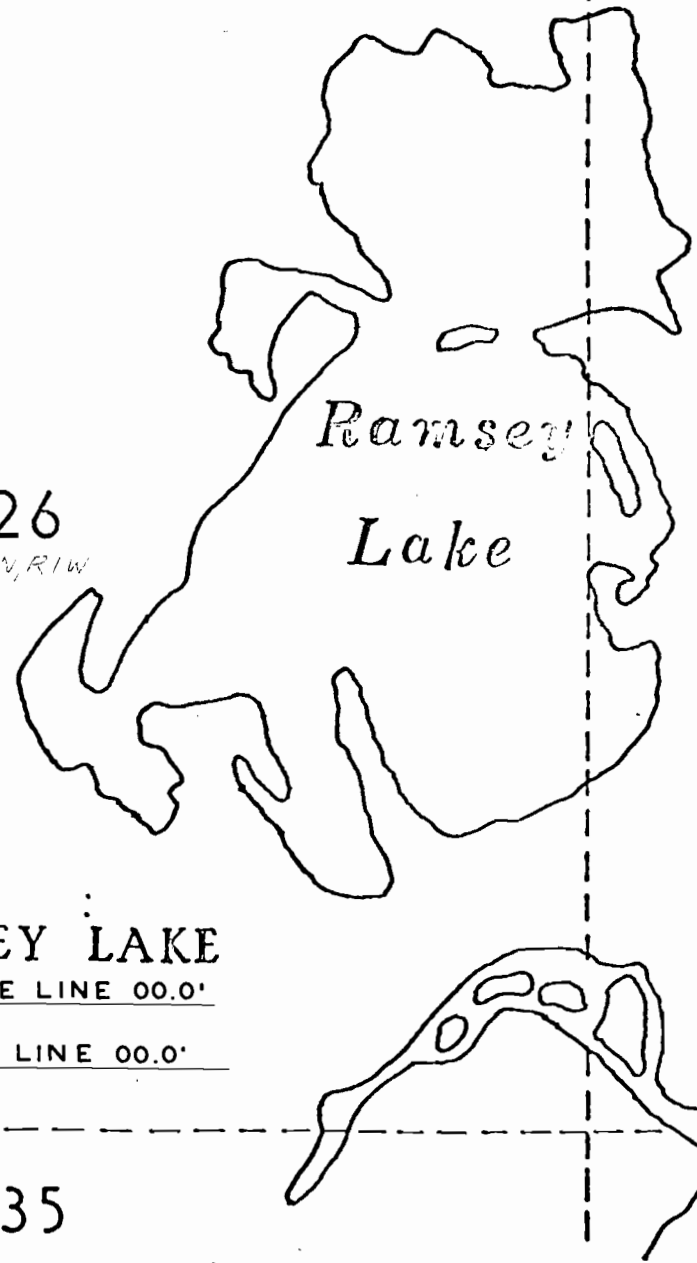


SCALE IN FEET

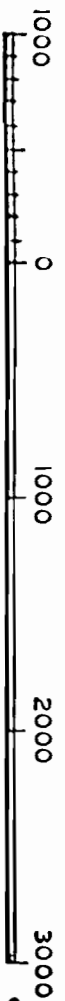

ASH GROVE LIME & PORTLAND CEMENT PLANT  
PORTLAND, OREGON

SITE PLAN

REVISED

The H. K. Ferguson Company

WELL LOCATION

APPROVED DATE 2-27-62

JOB 2273

Application No. G-2315  
Permit No. G-2333