


G-2342 15

35-6-5

T. 35 S. R. 6 W. W.M.

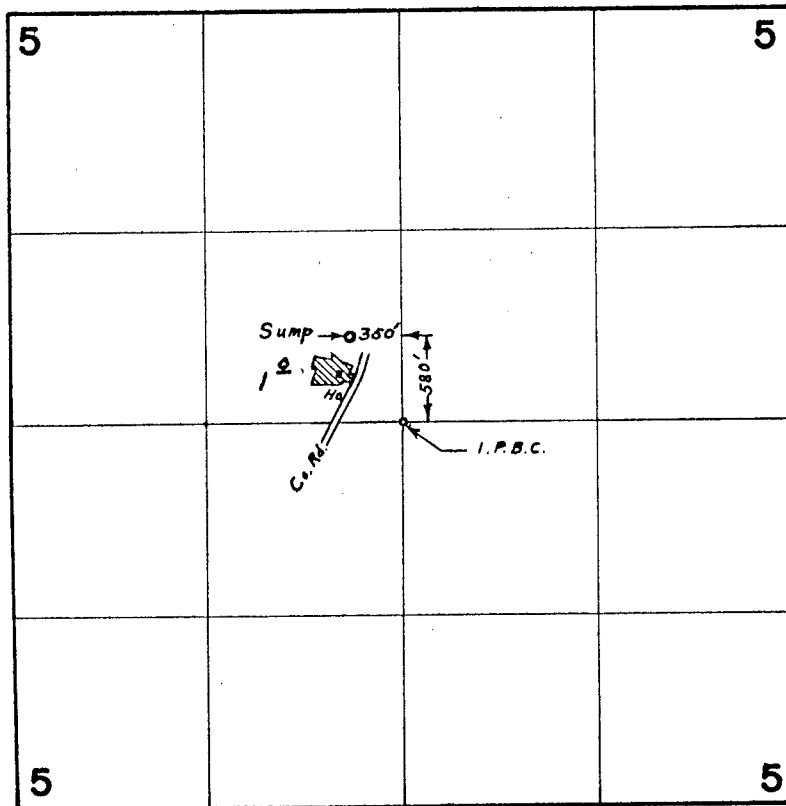

FINAL PROOF SURVEY

UNDER

Application No. G-2527 Permit No. G-2342

IN NAME OF

PAUL E. JONAS

Surveyed April 14, 1970, by L. E. Gould