


G-2455

39-5-7

T.39 S.R.5 W.W.M.

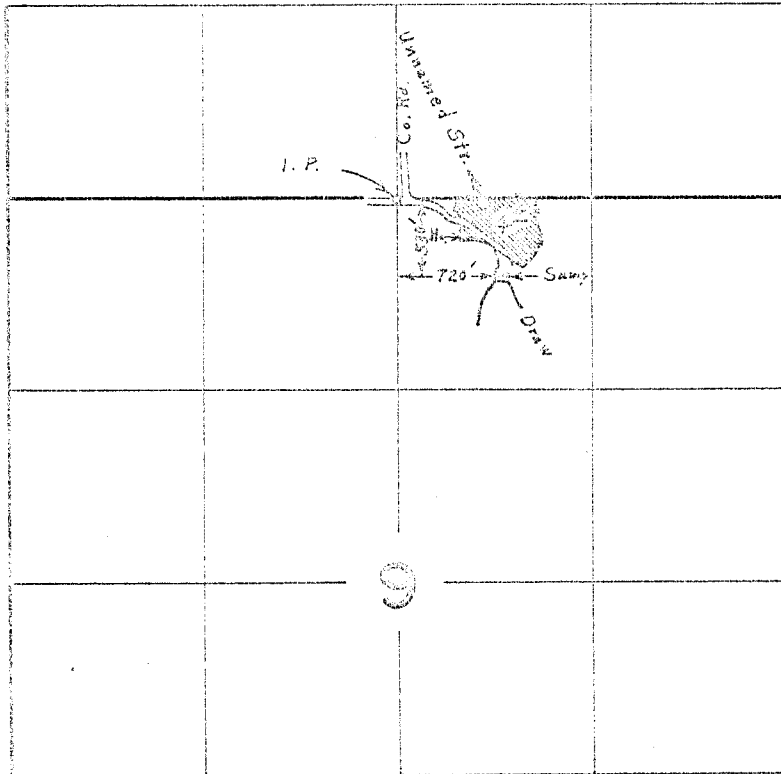

FINAL PROOF SURVEY
UNDER

Application No. G-2632 Permit No. G-2455
IN NAME OF

JIM C. COLEMAN

Surveyed Aug. 22, 1967, by L. E. Gould

1967-V