


# T. 3&4 S.R. 1 W. W.M.

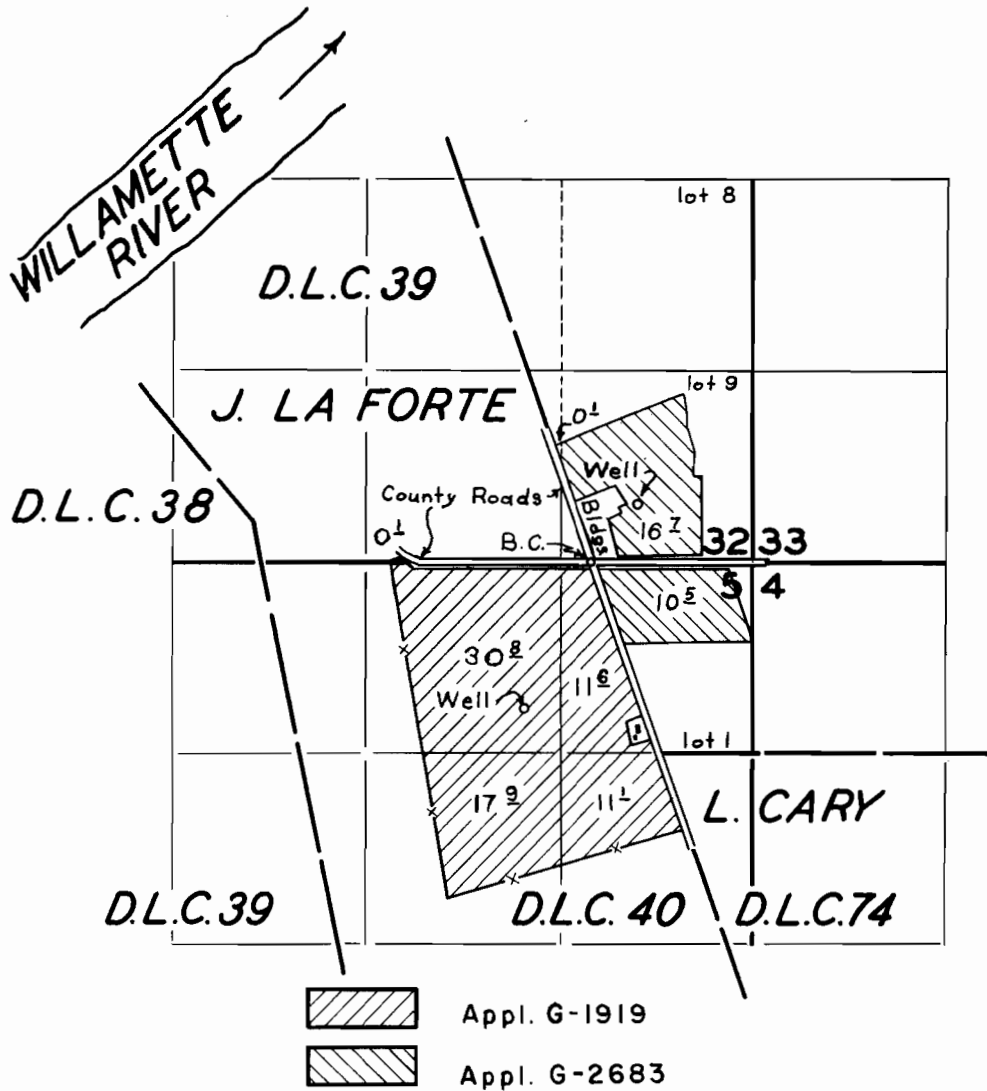

## FINAL PROOF SURVEY UNDER

Application No. G-1919 G-2683 Permit No. G-1774 G-2481  
IN NAME OF

SMITH & HUBBARD DAIRY

Surveyed June 25, 1964, by R. JACKSON