


G-2509

3-3-67

# T.38 S.R.5 W.W.M.

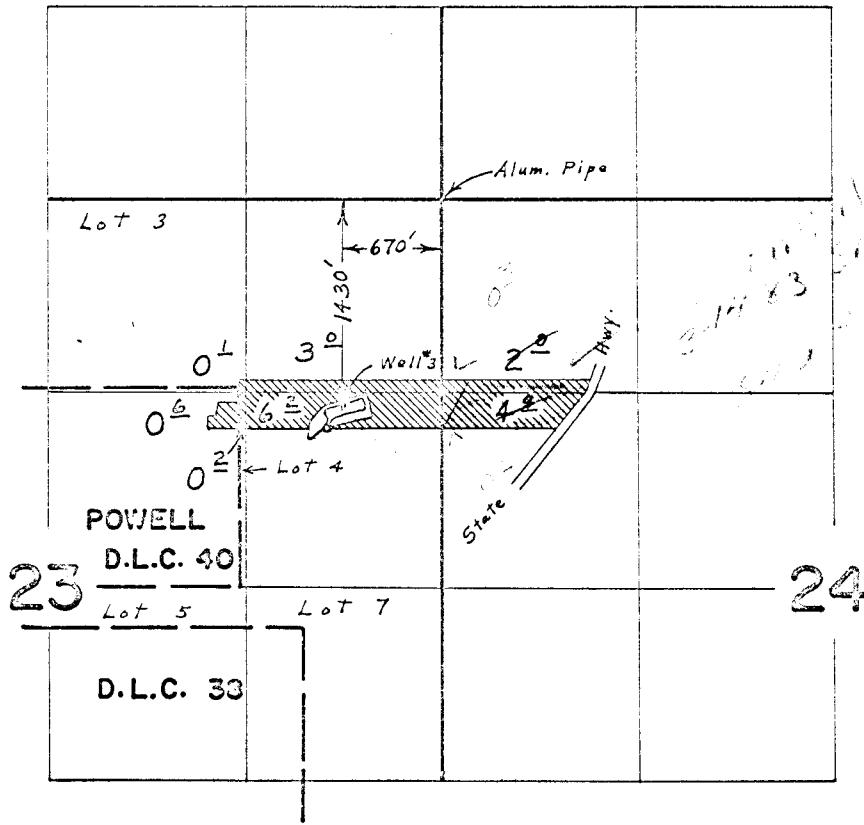

## FINAL PROOF SURVEY UNDER

Application No. G-2680 Permit No. G-2509  
IN NAME OF

JOHN H. KATZENBACH

Surveyed Aug. 23, 1967, by L. E. Gould