


Scale: 1 inch = 1,000 feet

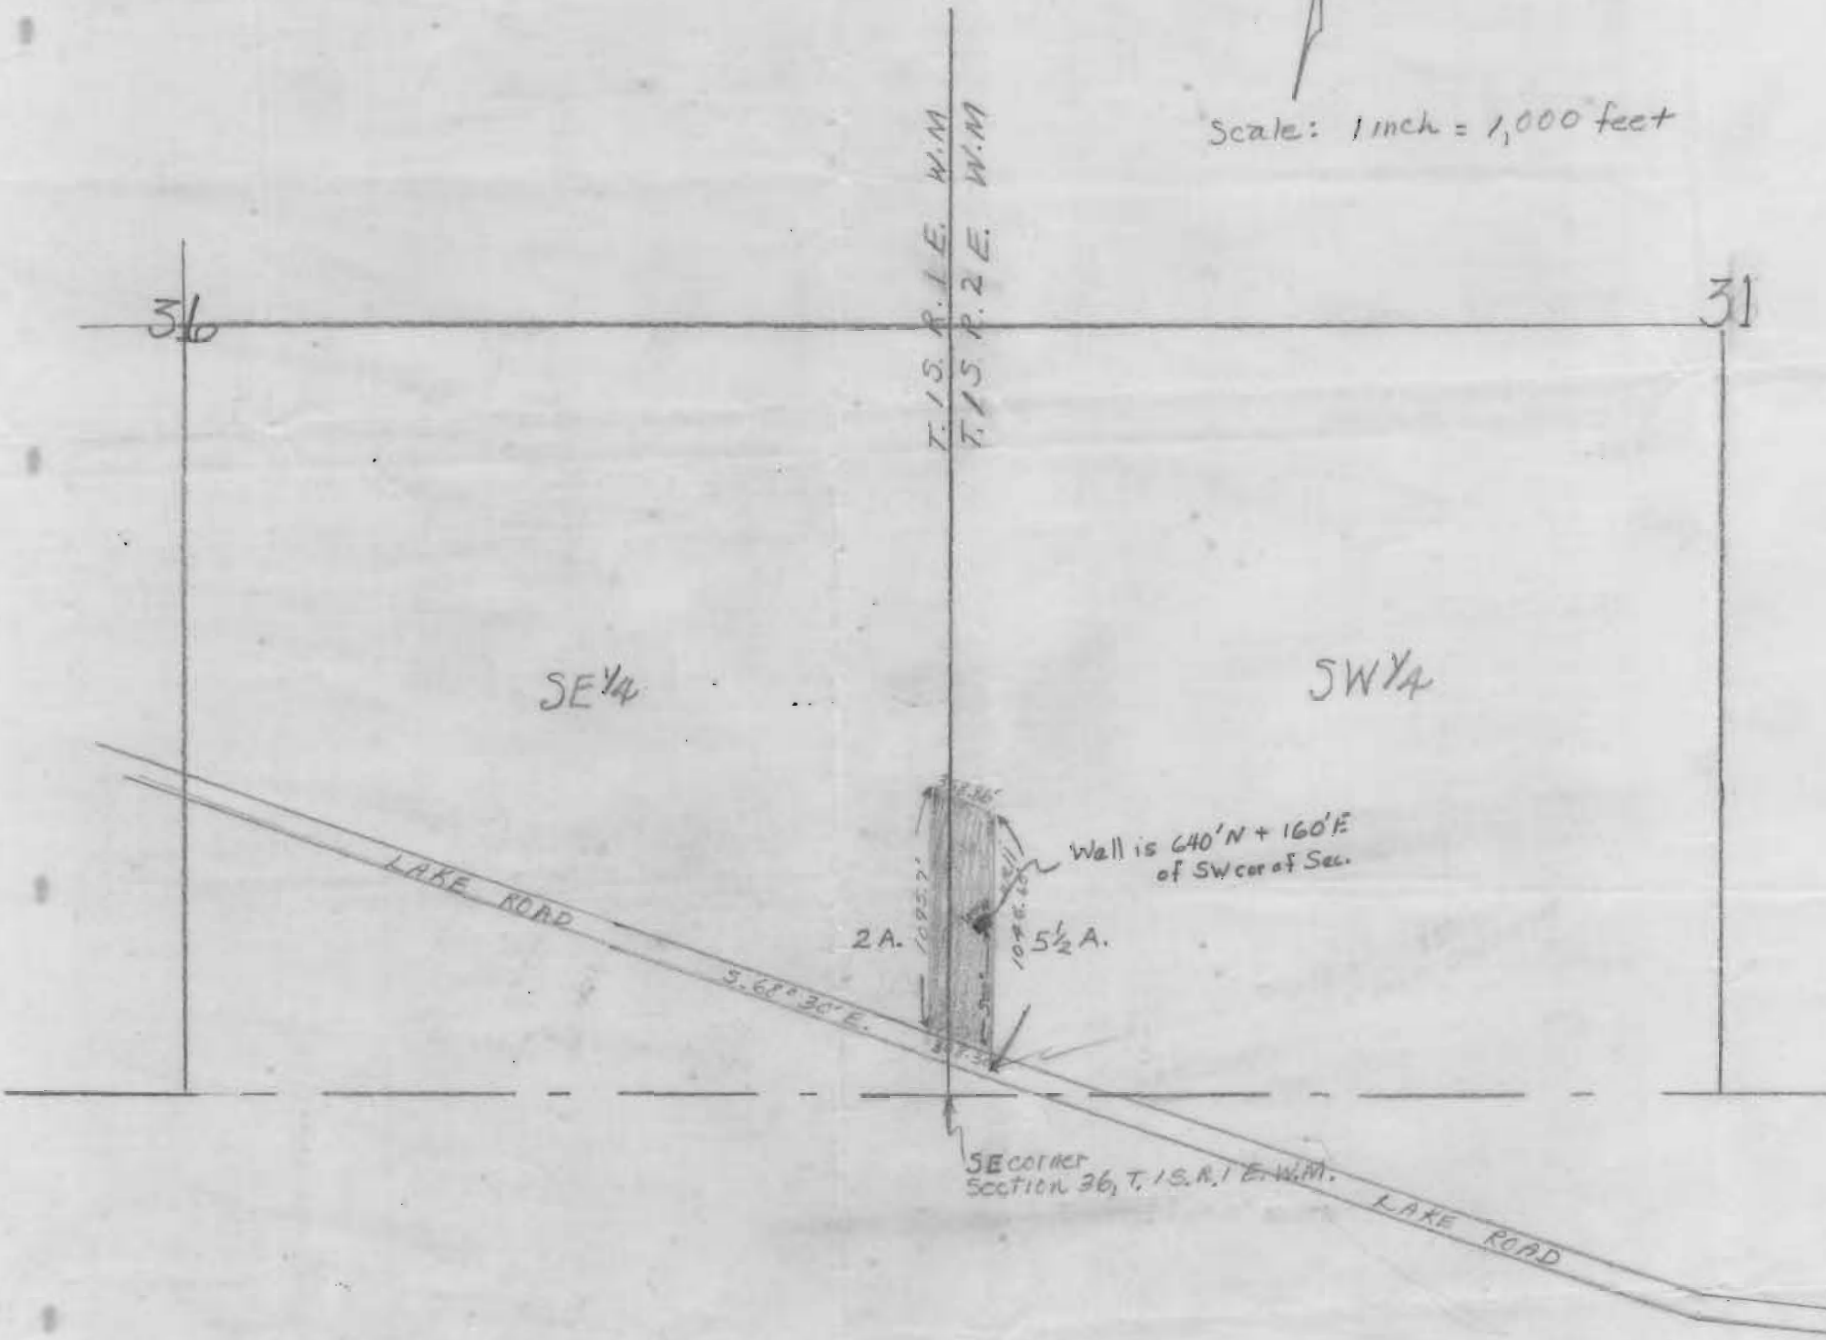

RECEIVED  
 JUN 13 1958  
 STATE ENGINEER  
 SALEM, OREGON

Application No. G-375  
 Permit No. G-251

G 375