


G-2513

25-6-6

T. 35 S. R. 6 W. W.M.

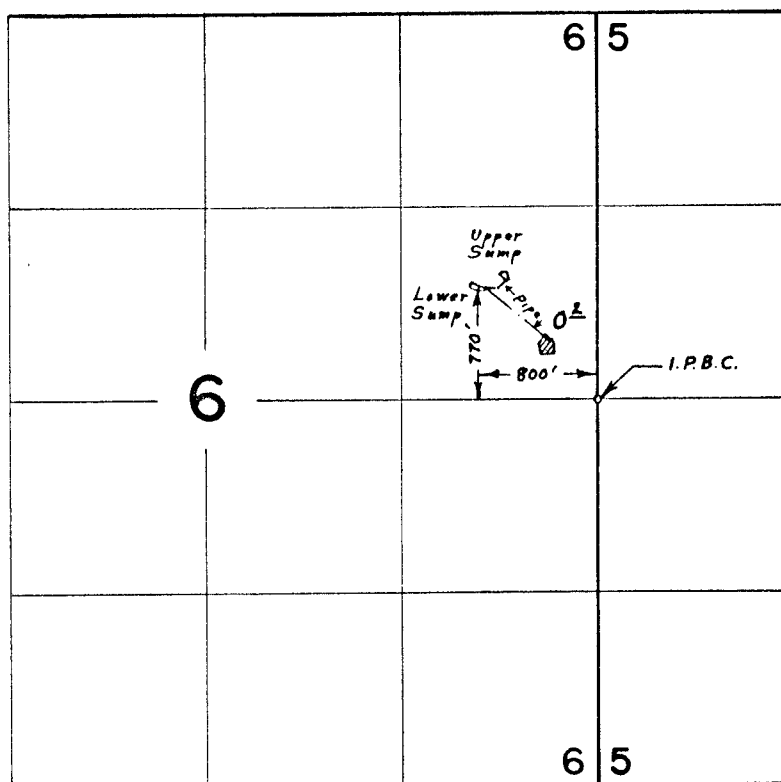

FINAL PROOF SURVEY UNDER

Application No. G-2705 Permit No. G-2513
IN NAME OF

GERALD W. & GERALD L. KINNEY

Surveyed April 15, 1970, by L. E. Gould