


G-2525

37-5-2

T.39S. R.5W.W.M.

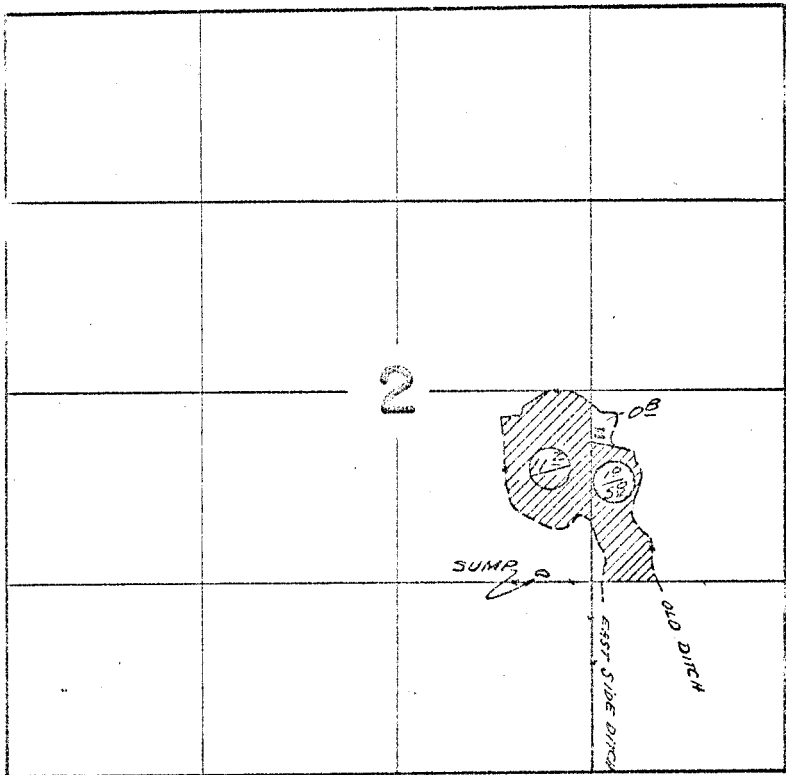

Sump located 70 ft. N. & 320 ft. W. from the SE cor. NW 1/4 SE 1/4 section 2

⊘ SUPPLEMENTAL
PRIMARY

FINAL PROOF SURVEY
UNDER

Application No. G-2726.. Permit No. G-2525.
IN NAME OF

NOAH J. and FAYE M. RIGEL

Surveyed May 24 1967., by V. Garner