


Water Right and Well Location Map
for
City of Union
Union, Oregon

Date November 25, 1963

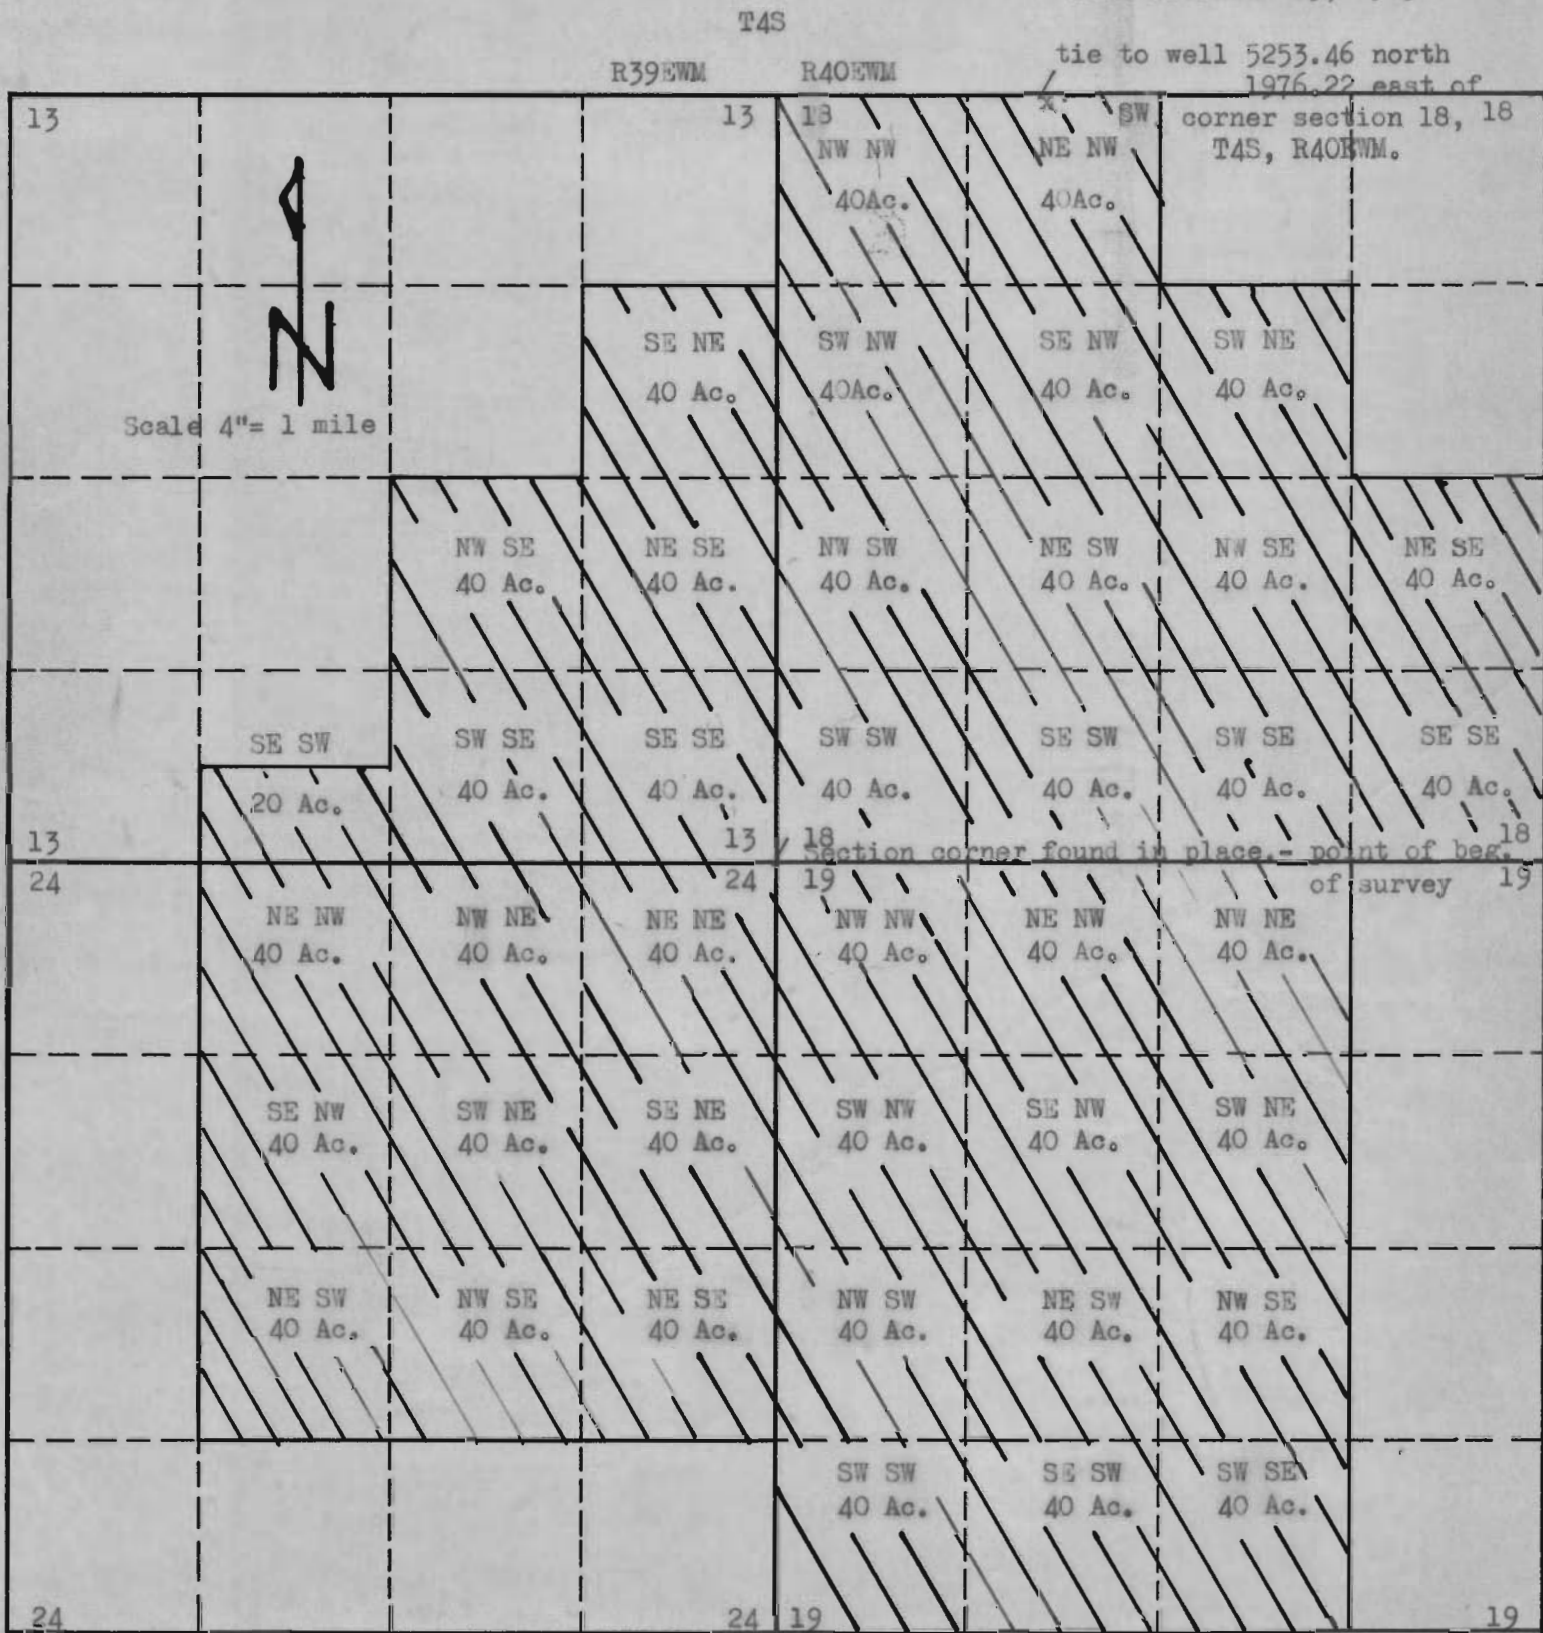

I certify this field tie to SW corner of Section 18, T4S, R40EWM, was made by me on November 14, 1963 and well was referenced to established SW corner of Section 18, T4S, R40EWM.



Application No. G-2745
Permit No. G-2541