


Per. G2549

37-5-11

T.37S.R.6W.W.M.

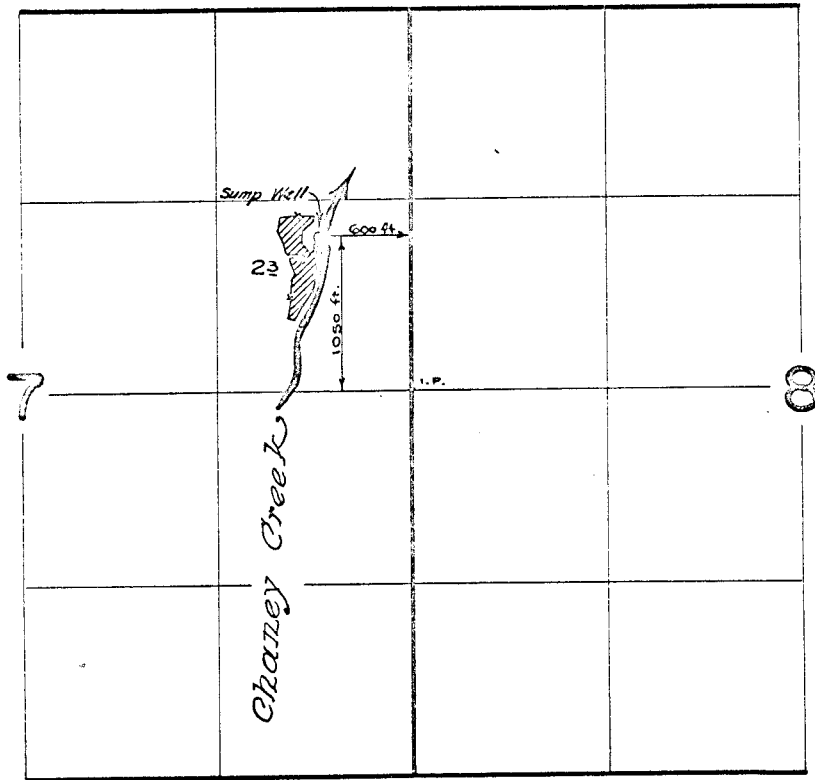

FINAL PROOF SURVEY
UNDER

Application No. G-2743 Permit No. G-2549
IN NAME OF

MANARD E. POWELL

Surveyed June 20 1905, by *Al Johnson*