


BOISE CASCADE CORPORATION ELGIN OREGON

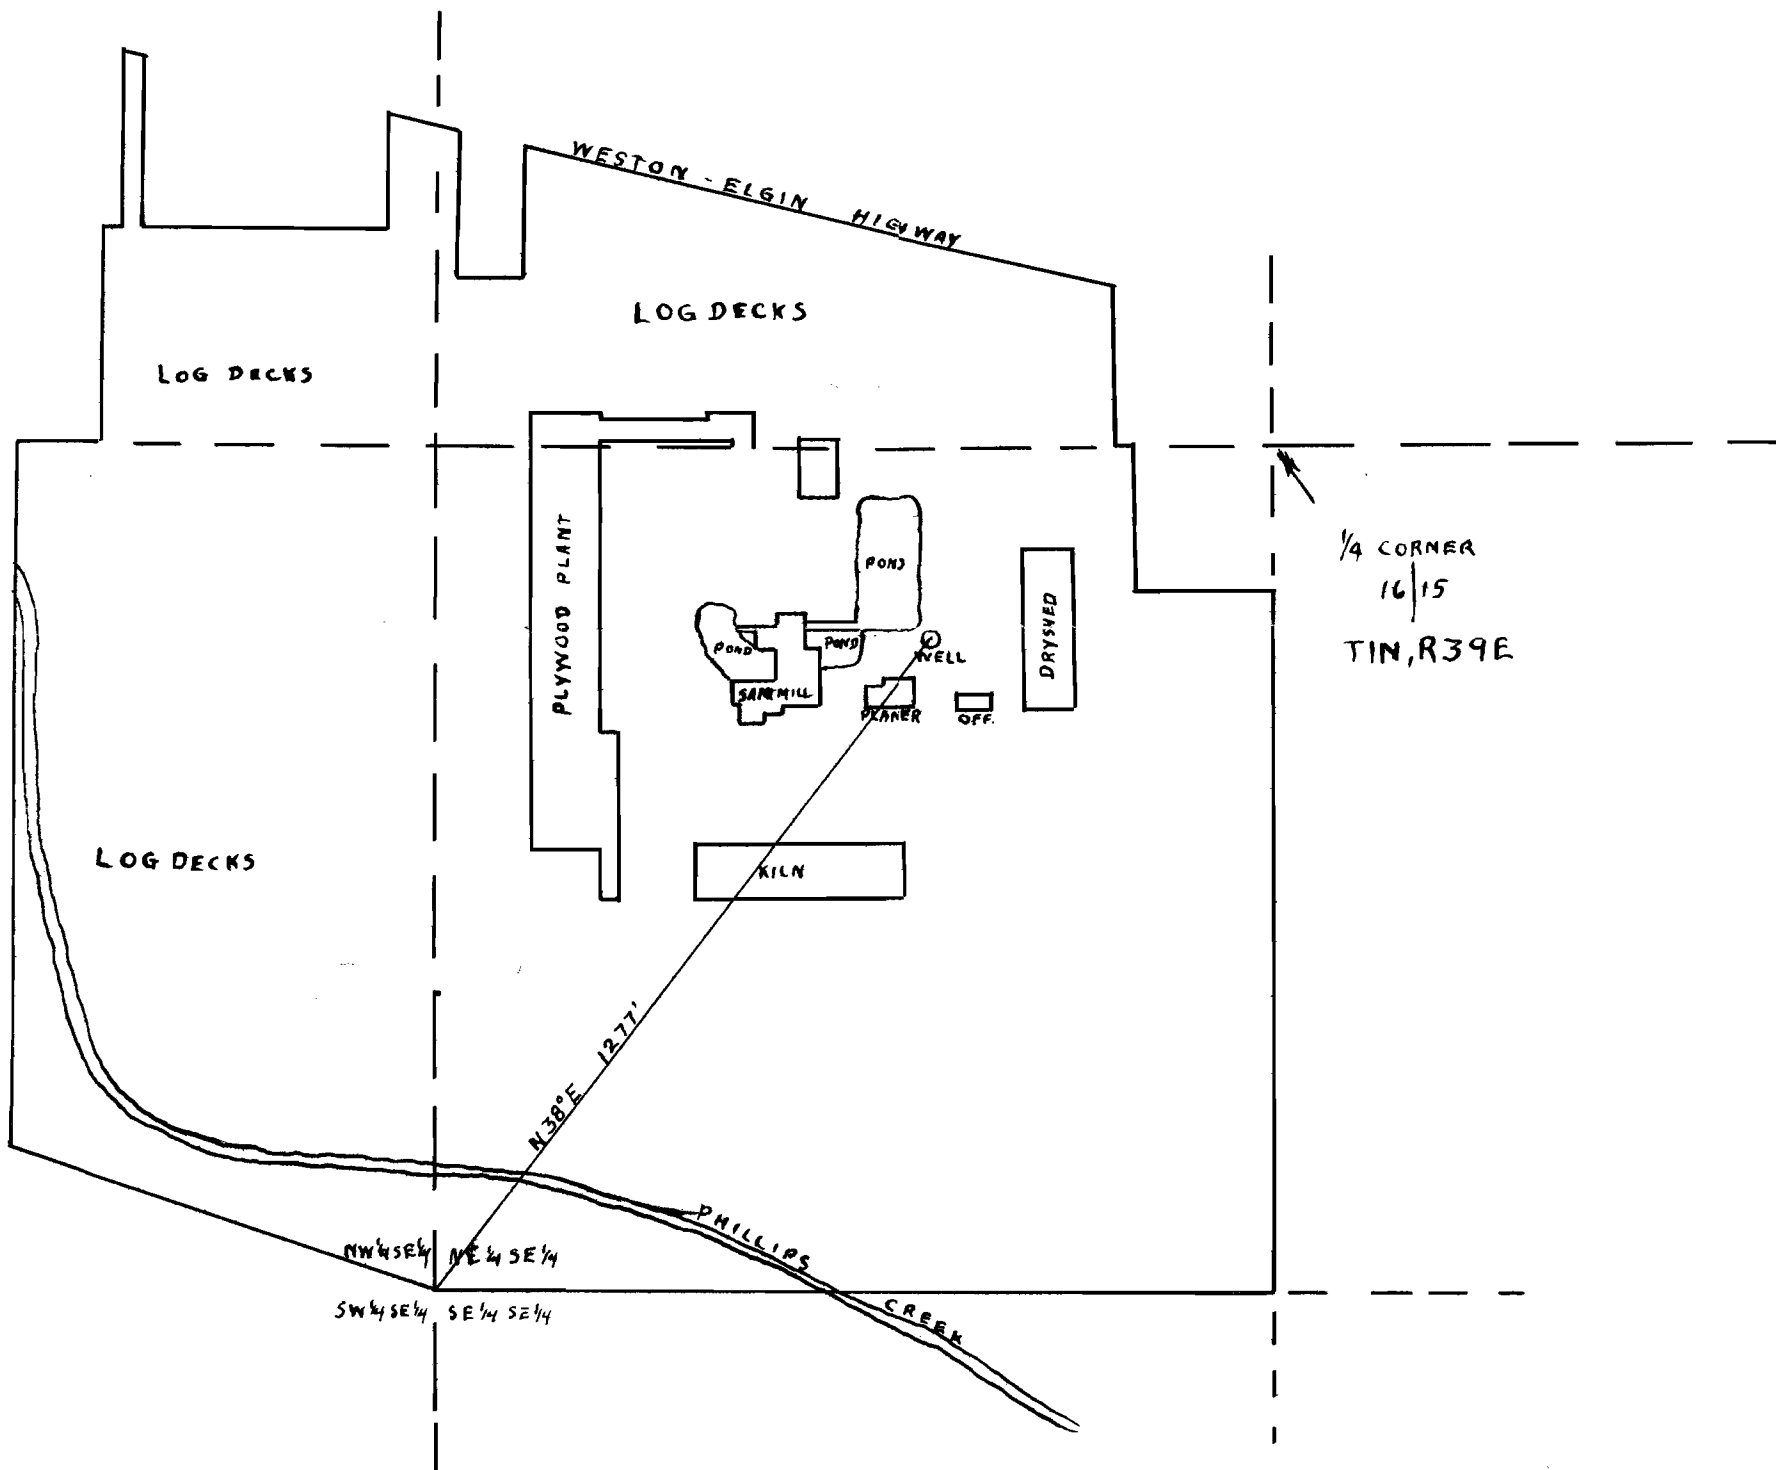

SCALE 1" = 300'
K&K

Application No G-2744
Permit No. G-2530