


Permit: G 2586
Volume: 4A
Strm: 11 WELLS
Trib: FRUITDALE CR
Priority: 12/03/63

T. 36 S. R. 5 W. W. IV.

RECEIVED
JUN 5 1978

WM. DIST. 14
GRANTS PASS, ORE

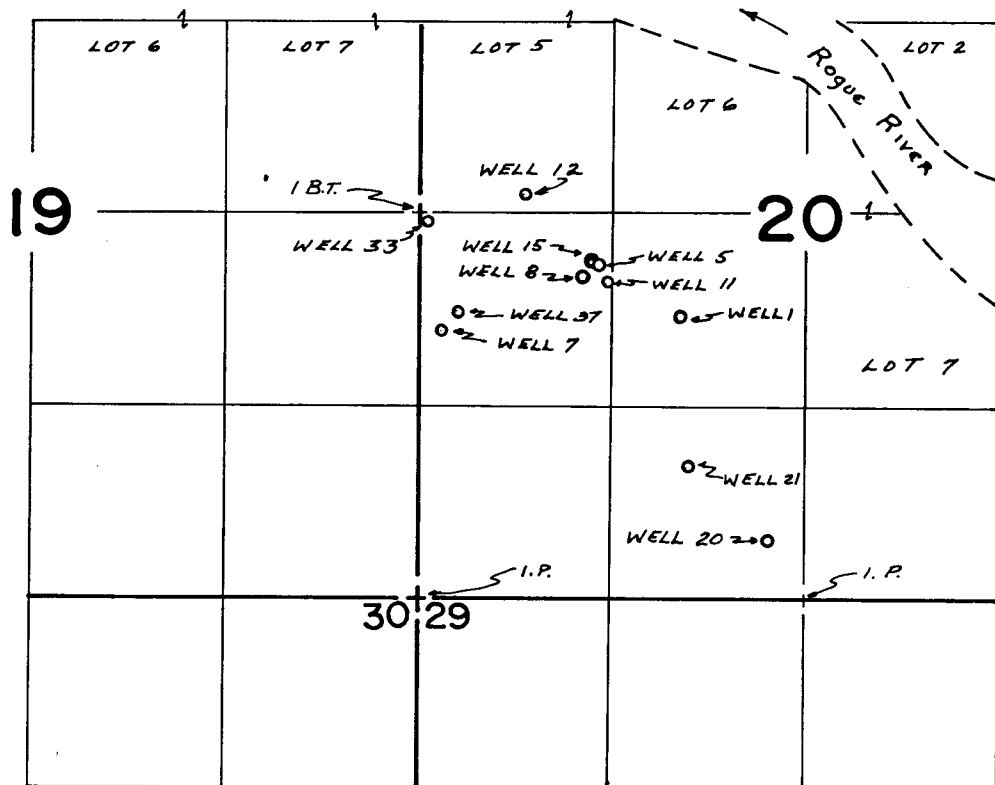

WELL LOCATIONS;
1 - 1940' N 850' W } ALL FROM S 1/4 COR. SEC. 20
20 - 400' N 260' W }
21 - 910' N 780' W }
7 - 780' S 160' E }
12 - 140' N 710' E } ALL FROM W 1/4 COR. SEC. 20
33 - 50' S 50' E }
37 - 660' S 270' E }
5 - 2300' N 1220' E }
8 - 2210' N 1110' E } ALL FROM NW COR. SEC. 29
11 - 2180' N 1270' E }
15 - 2320' N 1170' E }

FINAL PROOF SURVEY UNDER

Application No. G-2677 Permit No. G-258.6.
IN NAME OF

FRUITDALE WATER UTILITIES

Surveyed April 29, 1970, by L.E. Gould