


G-2606

45- - - 5,

T40S.R.6W.R.4A

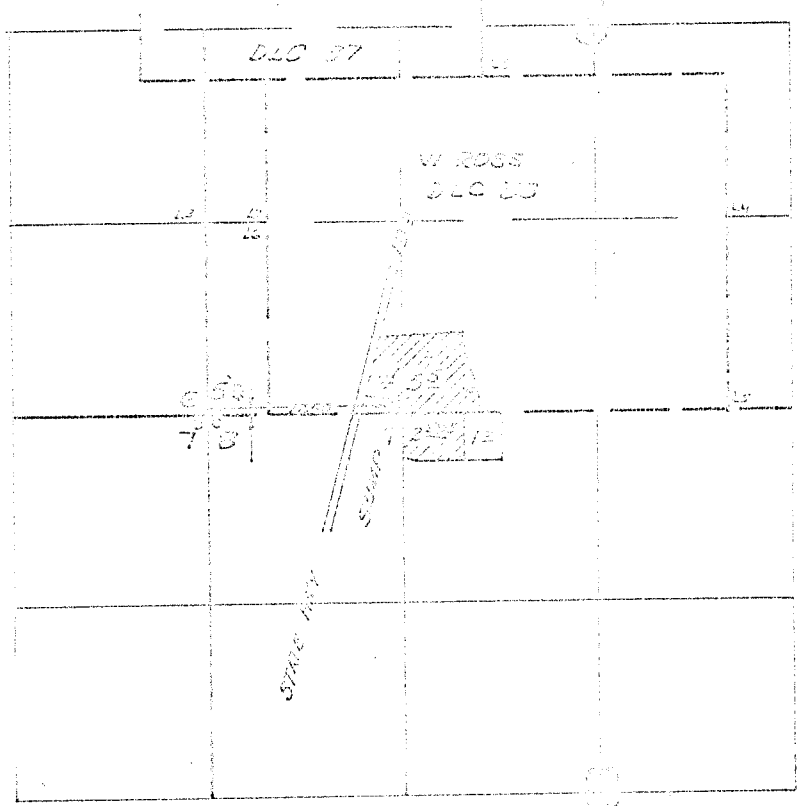

FINAL PROOF SURVEY UNDER

Application No. G2221... Partic No. 62222.  
IN NAME OF

ROBERT D. CHERRY

Surveyed May 18, 1951, by V. Gardner

1957-5