

SW 1/4 of NE 1/4
sec. 6

SE 1/4 of NE 1/4
sec. 6

SW 1/4 of NW 1/4
sec. 5

NW 1/4 of SE 1/4
Sec 6

NE 1/4 of SE 1/4
sec 6

NW 1/4 of SW 1/4
sec 5

SW 1/4 of SE 1/4
Sec. 6

SE 1/4 of SE 1/4
sec. 6

SW 1/4 of SW 1/4
Sec 5

Willamette Manor
1"=200' Jan 1964

Robert W. Straub
Rt 4 Box 111
Eugene, Oregon

Total Lots in entire subdivision
Approx 200

Min Lot Size 8500 Sq. ft.

N. 89° 13' 58" W
SE Corner R.R. Harper
D.L.C. # 66. in Sec 6
T. 18S, R. 2W. W.M.

1st Well
Bears East 1188'±
and South 1014'±
from S.E. Cor. R.R.
Harper D.L.C. # 66

RECEIVED
JAN 10 1964
STATE ENGINEER
SALEM, OREGON

Willamette Manor, in Sections 5
and 6 T. 18S, R. 2W. W.M.
Partially in R.R. Harper D.L.C. # 66
in Sec 6, T. 18S, R. 2W. W.M.
All in Lane County, Oregon


R. L. FOLLETT & ASSOCIATES
R.L.F. 1"=200'
61-25

Ralph J. Follett

Application No G-2761
Permit No. G-2643

61-25

Bob Straub

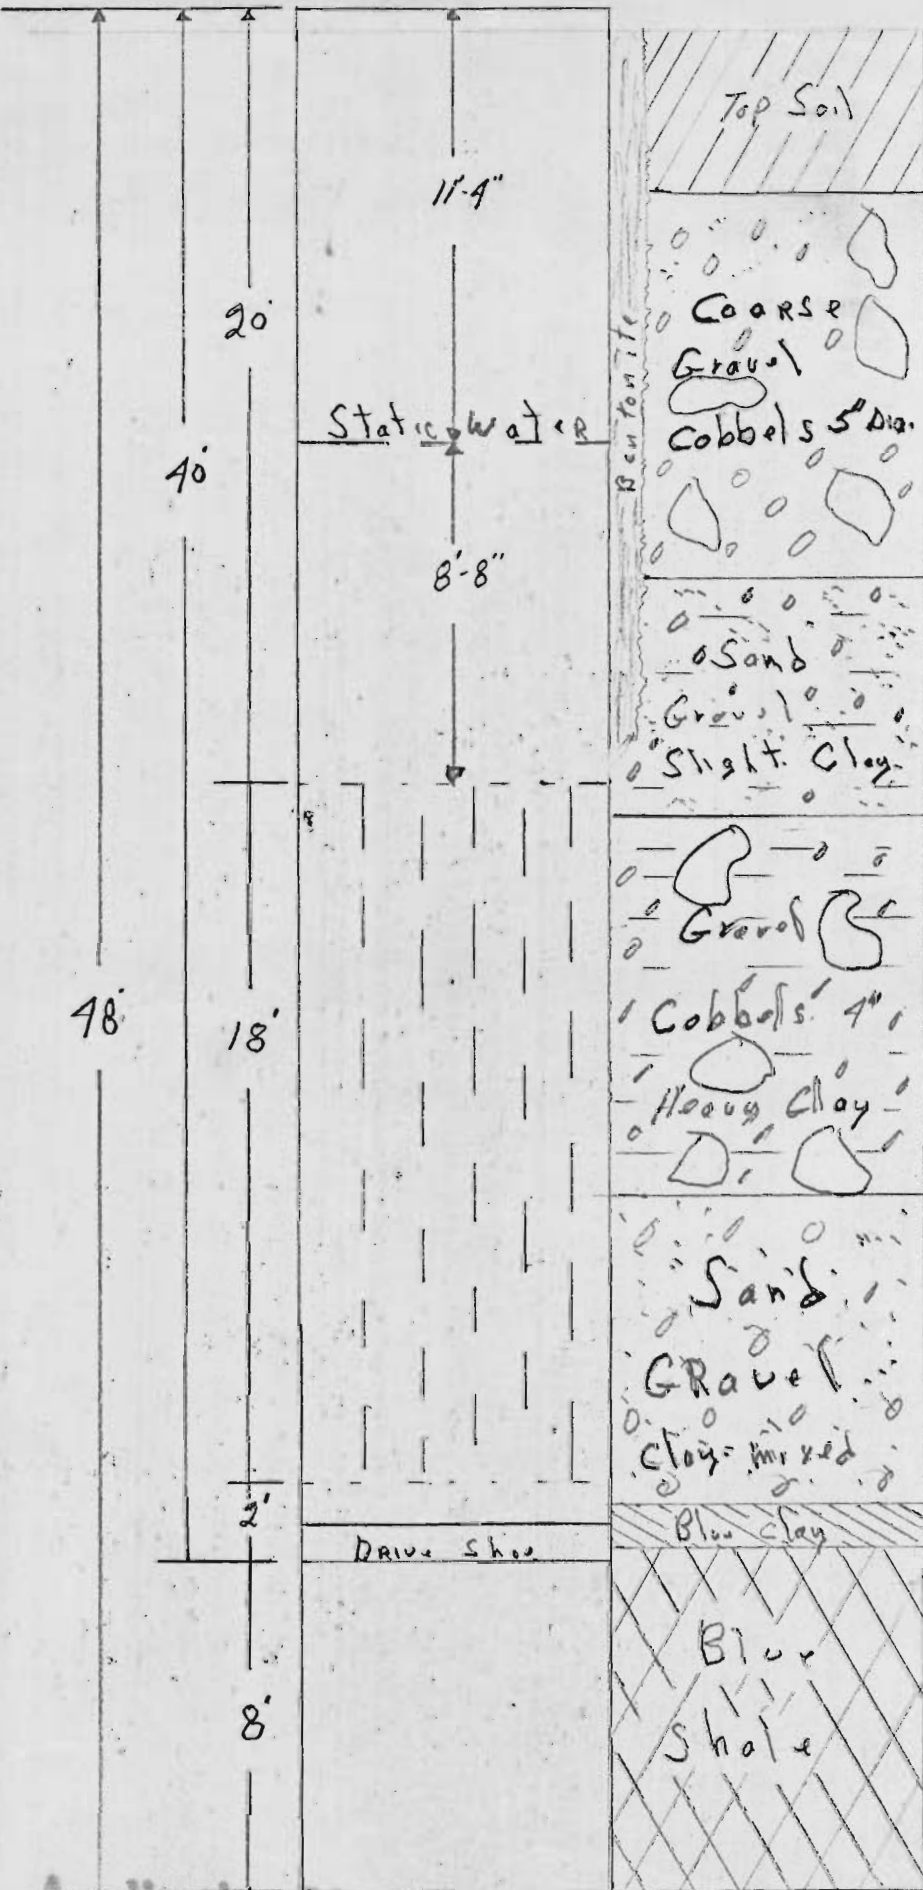

JAN

Excavation No. G-2761
G-2643