


T. 8 S. R. 1 W. W. M.

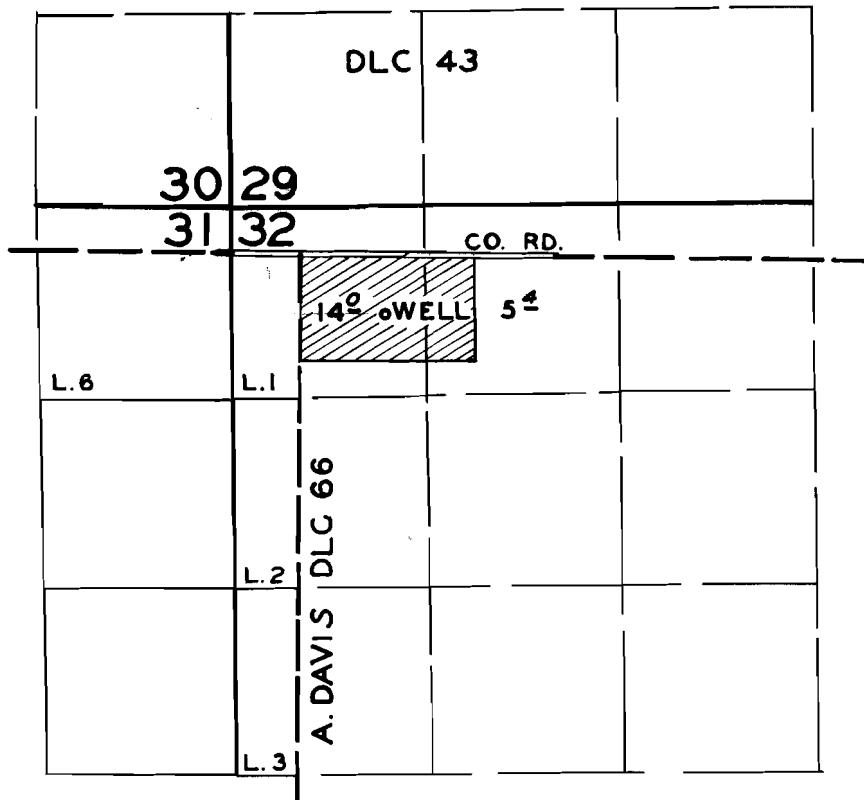

**FINAL PROOF SURVEY**  
UNDER

Application No. G. 393 Permit No. G. 265  
IN NAME OF

DANIEL J. ELBERT

Surveyed MAY 18 1980, by G. O. BARTELS