


N 1/4 Corner
Sec. 4 - T. 155 N. R. 16 E. W. M.

Land in N.E. 1/4 of Sec. 4 - T. 155 N. R. 16 E. W. M.
Owned by Wm. Endicott.

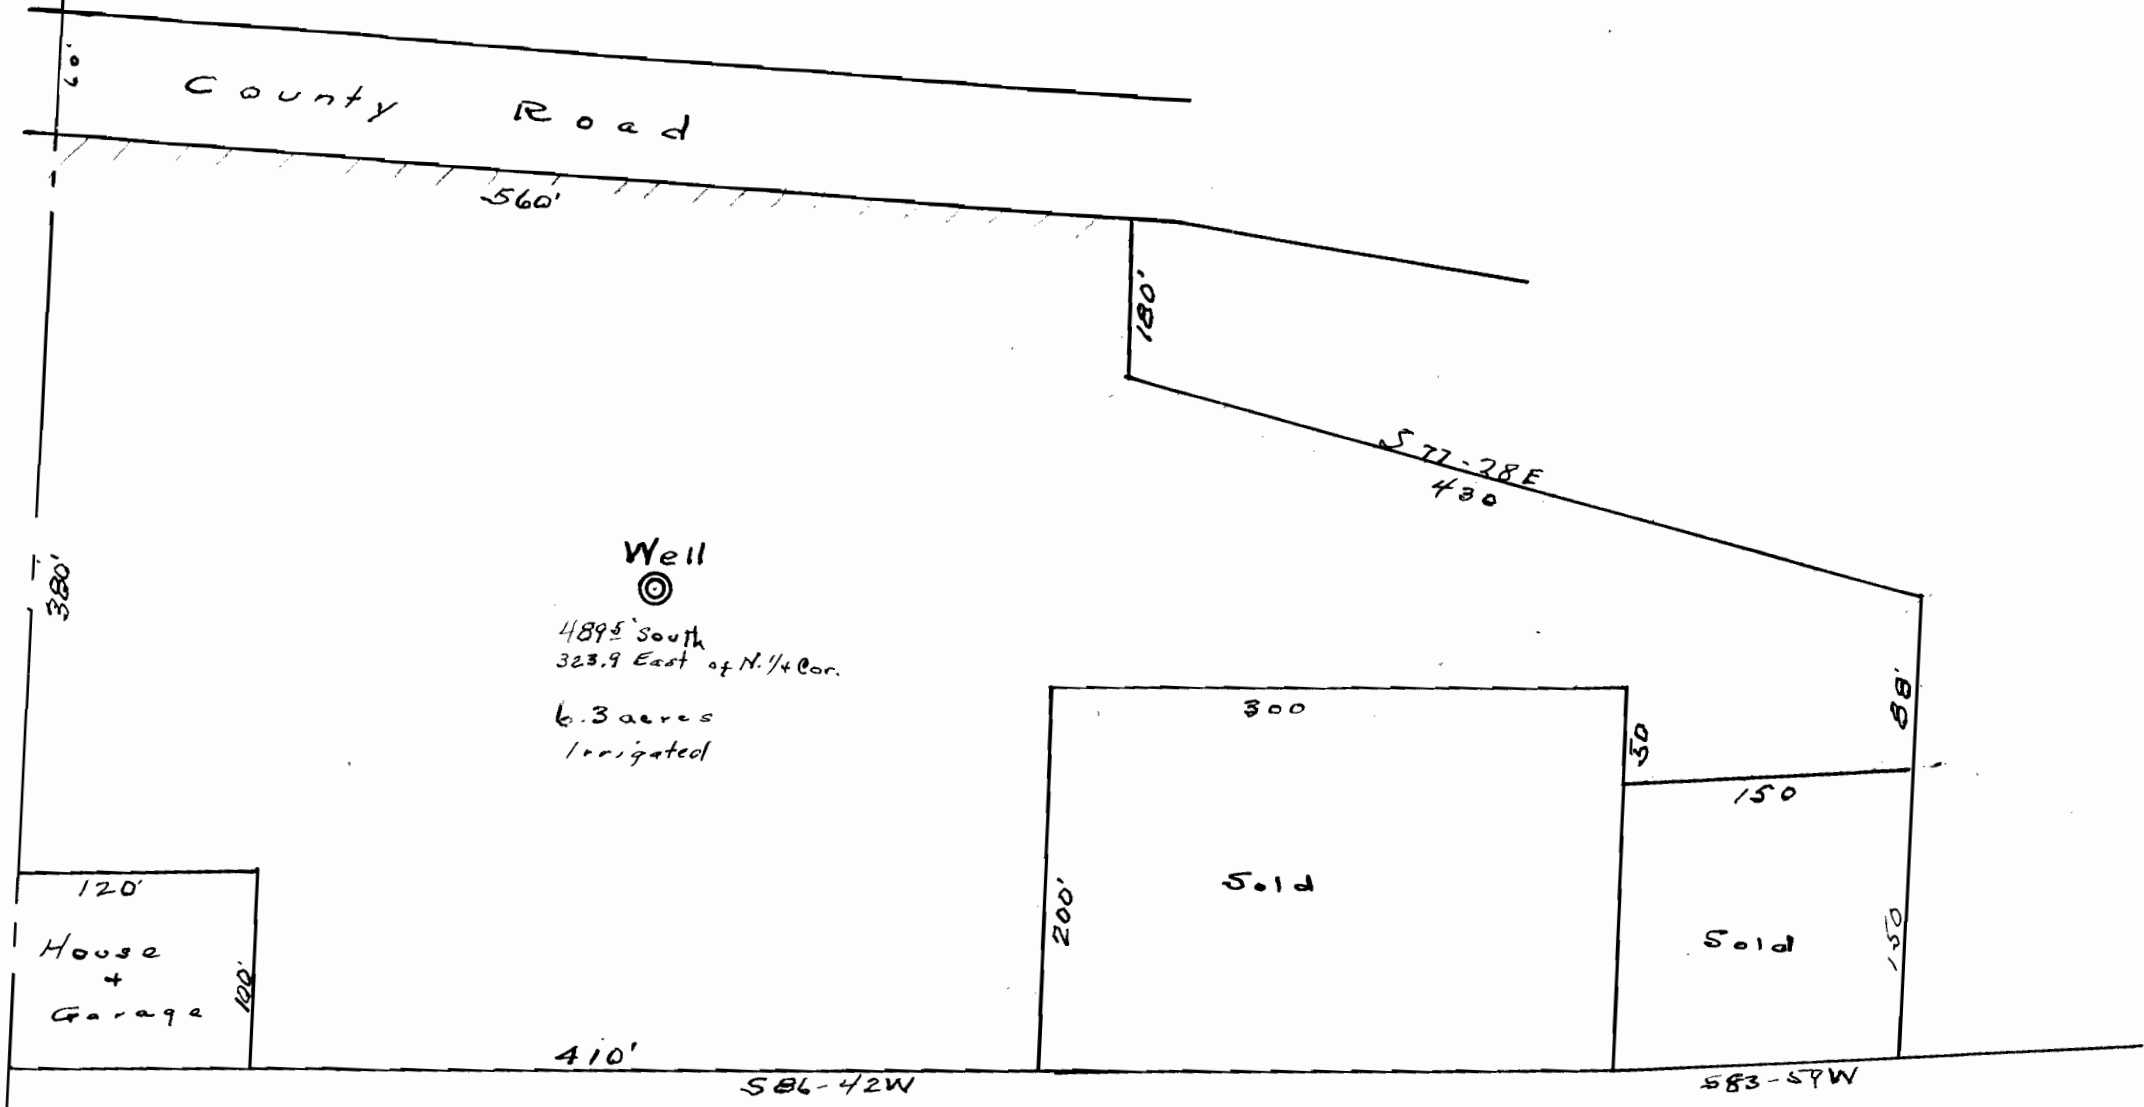

Ochoco

Highway

Scale 1" = 100'