


G-2722

40-11-5

T.39 S. 40 S. R.7 E. 8 W. W.M.

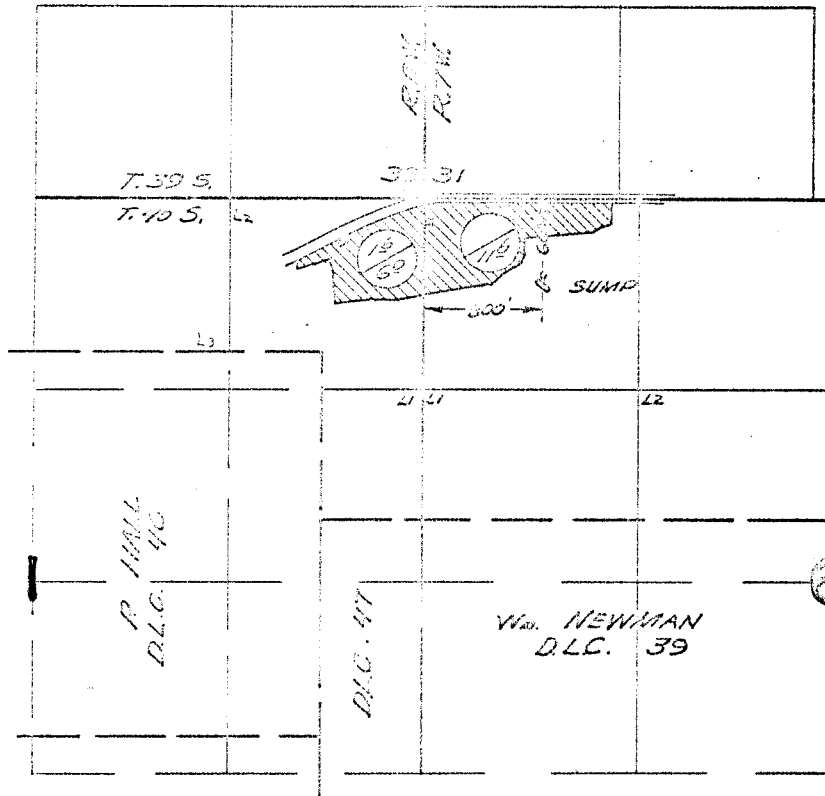

FINAL PROOF SURVEY
UNDER

Application No. G-2799. Permit No. G-2722.
IN NAME OF

WARD WILSON

Surveyed May 20, 1967, by V. Garner

1967-C