


T. 37 S., R. 5 W., W. M.

RECEIVED

MAR 30 1987

WM. DIST. 14
GRANTS PASS, ORE

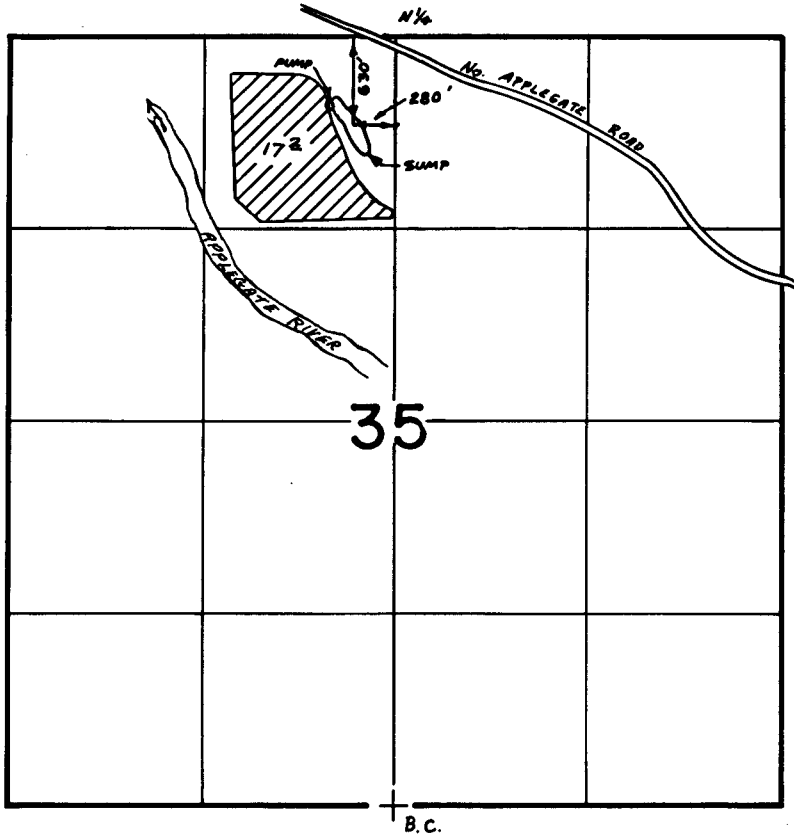

Scale : 4" = 1 Mile

FINAL PROOF SURVEY
UNDER

Application No. G-3062 Permit No. G-2855...
IN NAME OF

.....JOHN.....McMAHON.....

Surveyed May.....6..... 1982, by B.R. SUND.....