


T. 7 S. R. 2 W.

1" = 10 chains

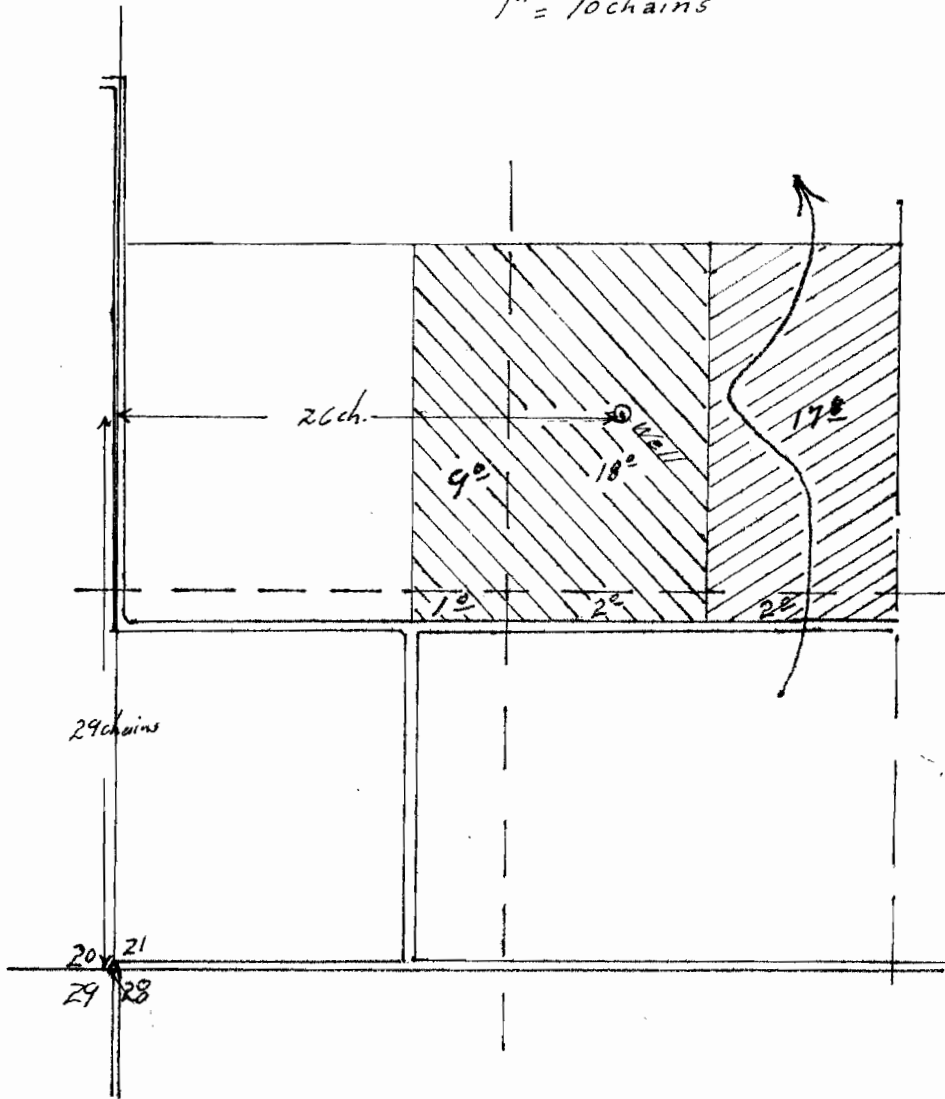

Application No. G-3183
Permit No.