

# T. 37 S., R. 7 W., W.M.

RECEIVED


OCT 20 1986

WM DIST. 1A  
GRANTS PASS, ORE.

for G-3228:

|||| supplemental

//// primary

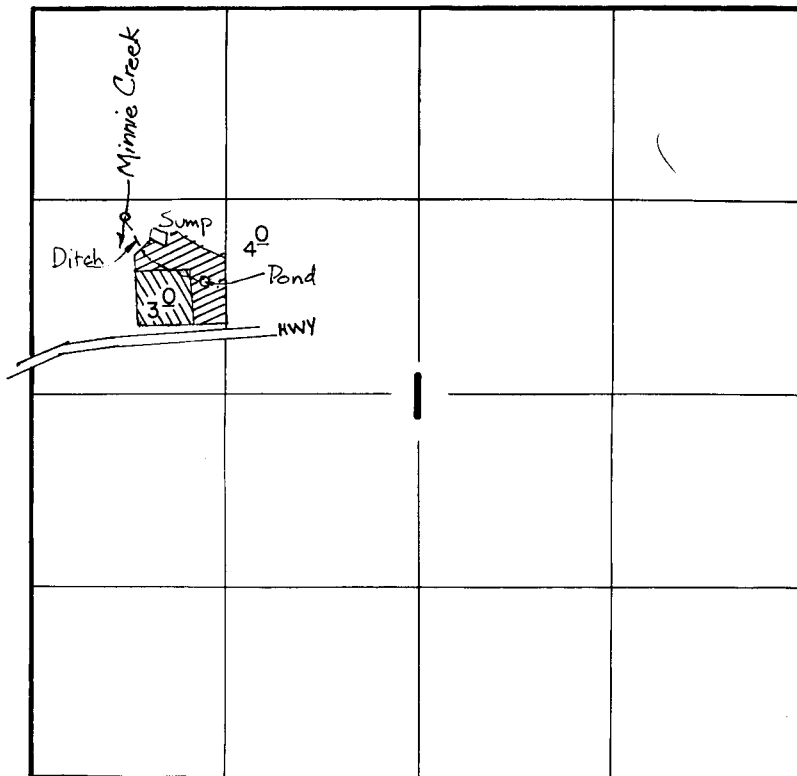

MINNIE CREEK Div. Pt. 120' S. & 680' W.  
 SUMP Div. Pt. 240' S. & 450' W.  
 POND Div. Pt. 560' S. & 150' W.  
 All located from N.E. Cor. S.W. 1/4 N.W. 1/4 Sec. 1.

## FINAL PROOF SURVEY UNDER

41355                      30892

Application No. G-3228 Permit No. G-3036....  
 IN NAME OF

.....*Robert and Jean Sweat*.....

Surveyed AUG. 13, 1982, by B. S. JAMES.....

B50-3-13