
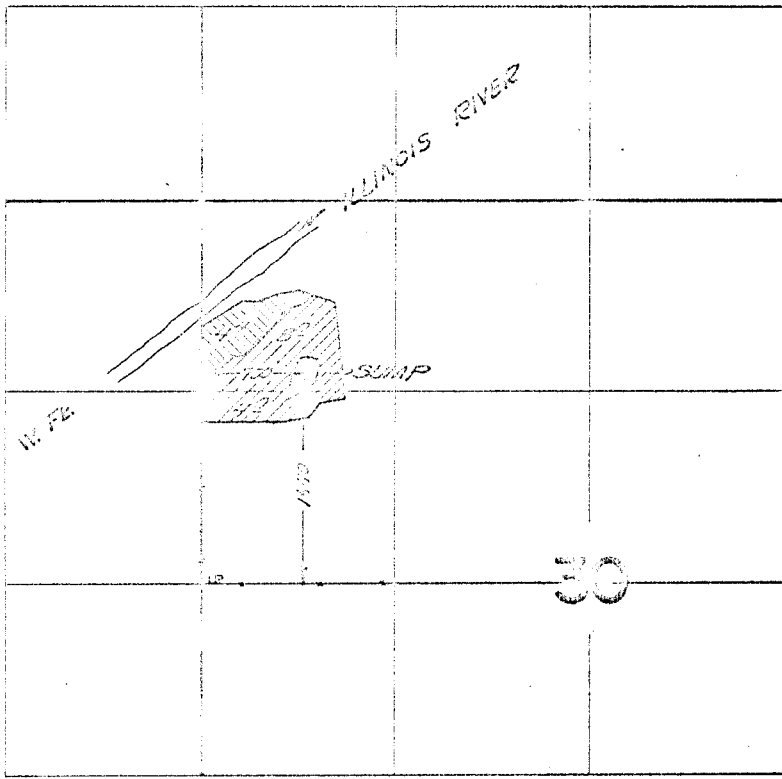
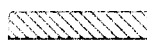


G-3045

410-8-30

T400 R.S.W. W.M.

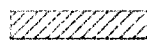

 PRIMARY
  SUPPLEMENTAL

FINAL PROOF SURVEY
UNDER

Application No. G:3242. Permit No. G:3045.
IN FAVOR OF

..... G.E. ROSS

Surveyed May 17, 1967, by V. Garner.....