


G-3069 15

T. 38 S. R. 8 W. W.M.

According to a phone call from Ralph Jackson 3/14/72 the legend should have been omitted from this map. The 2.8 Ac. of irrigation as shown in the SW $\frac{1}{4}$ NE $\frac{1}{4}$ is correct. In the NE $\frac{1}{4}$ SE $\frac{1}{4}$ there is only .4 Ac. and the exact location is unknown.

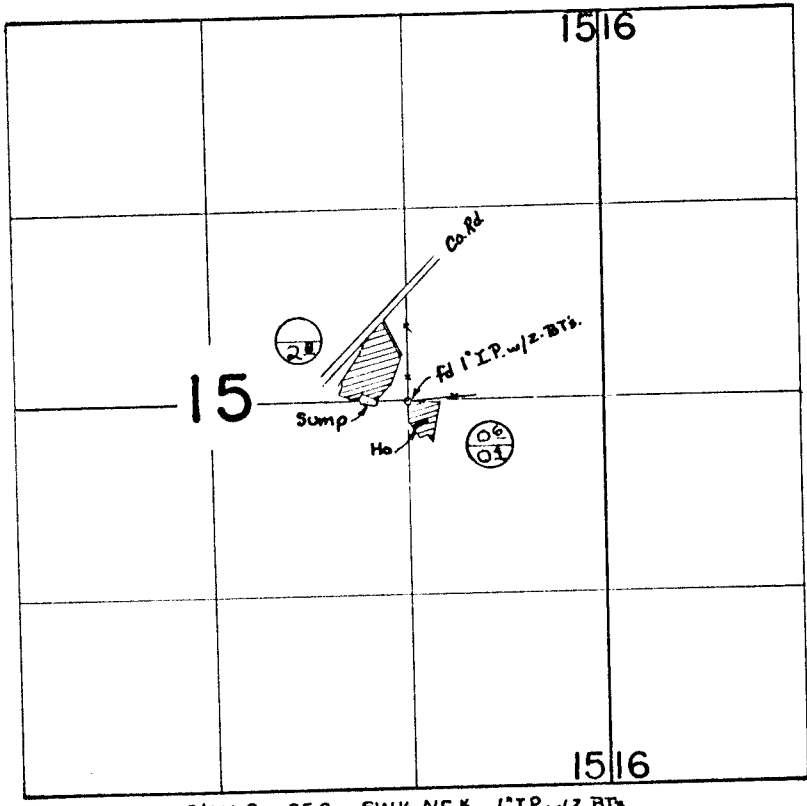

Sump Loc. 270' W fm. SE Cor. SW $\frac{1}{4}$ NE $\frac{1}{4}$, 1' IP. w/ 2 BTs.

○ Primary
○ Supplemental to Permit 25812

FINAL PROOF SURVEY UNDER

Application No. G 3283 Permit No. G 3069
IN NAME OF

ROBERT J. LANFRANCO

Surveyed 29 APRIL 1970, by D.R. BUELL

RTA 65