



N.W. CORNER OF SECTION 3
T. 15, R. 1E, W.M.

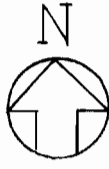

2620 FT

RECEIVED
DEC 8 1965
STATE ENGINEER
SALEM OREGON

RECEIVED
NOV 9 1965
STATE ENGINEER
SALEM OREGON

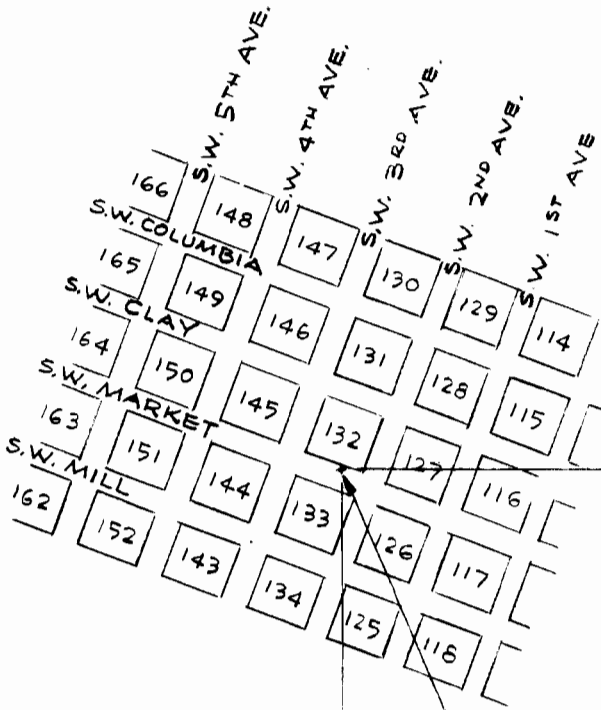

CIVIC AUDITORIUM
WELL

WILLAMETTE RIVER

1110 FT

NOTE :
ALL DIMENSIONS ARE APPROXIMATE

Appurtenance No. G-3314
Permit No. G-3086

S.W. CORNER OF SECTION 3
T. 15, R. 1E, W.M.

LOCATION OF
CIVIC AUDITORIUM WELL
PORTLAND, OREGON

SCALE : 1" = 600' APPROX

10-19-65