


G-3358
36-5-31

T.36 & 37 S. R.5 W. W.M.

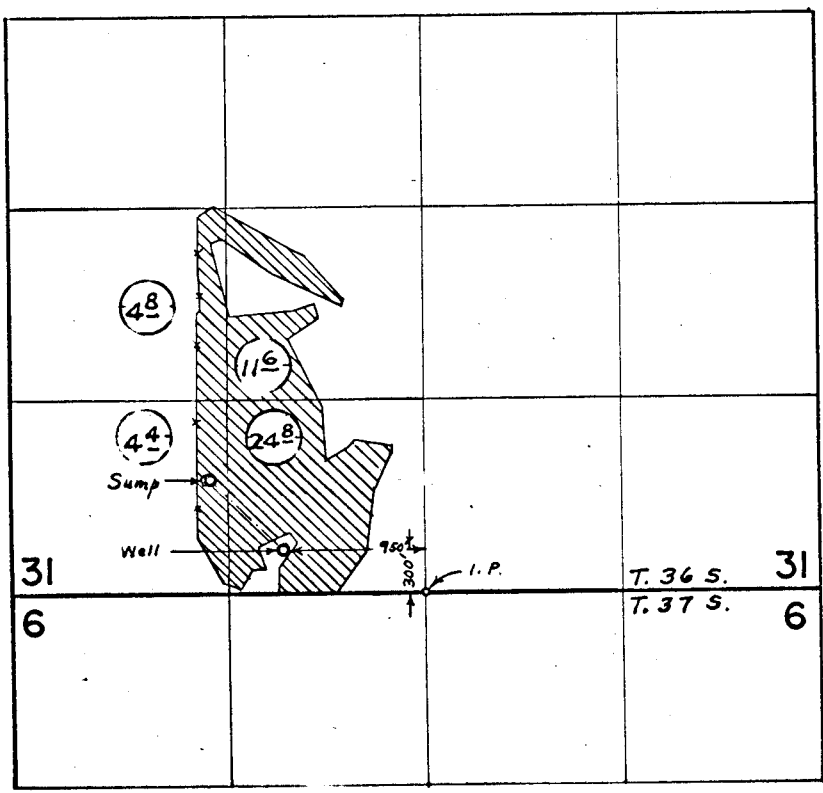

FINAL PROOF SURVEY
UNDER

Application No. G-3358 Permit No. G-3151
IN NAME OF
GRANTS PASS GOLF CLUB, INC.
Surveyed Aug. 28, 1967, by L. E. Gould