


I, GEORGE L. DUCRET OF THE U.S. DEPT. OF THE INTERIOR F&W SERVICE DO HEREBY CERTIFY THAT THIS MAP WAS MADE FROM NOTES TAKEN DURING AN ACTUAL SURVEY MADE BY ME (OR UNDER MY IMMEDIATE SUPERVISION) IN JULY 1962.

George L. Ducret
CIVIL ENGINEER
U.S. DEPARTMENT OF THE INTERIOR

T. 3 S., R. 5 E.

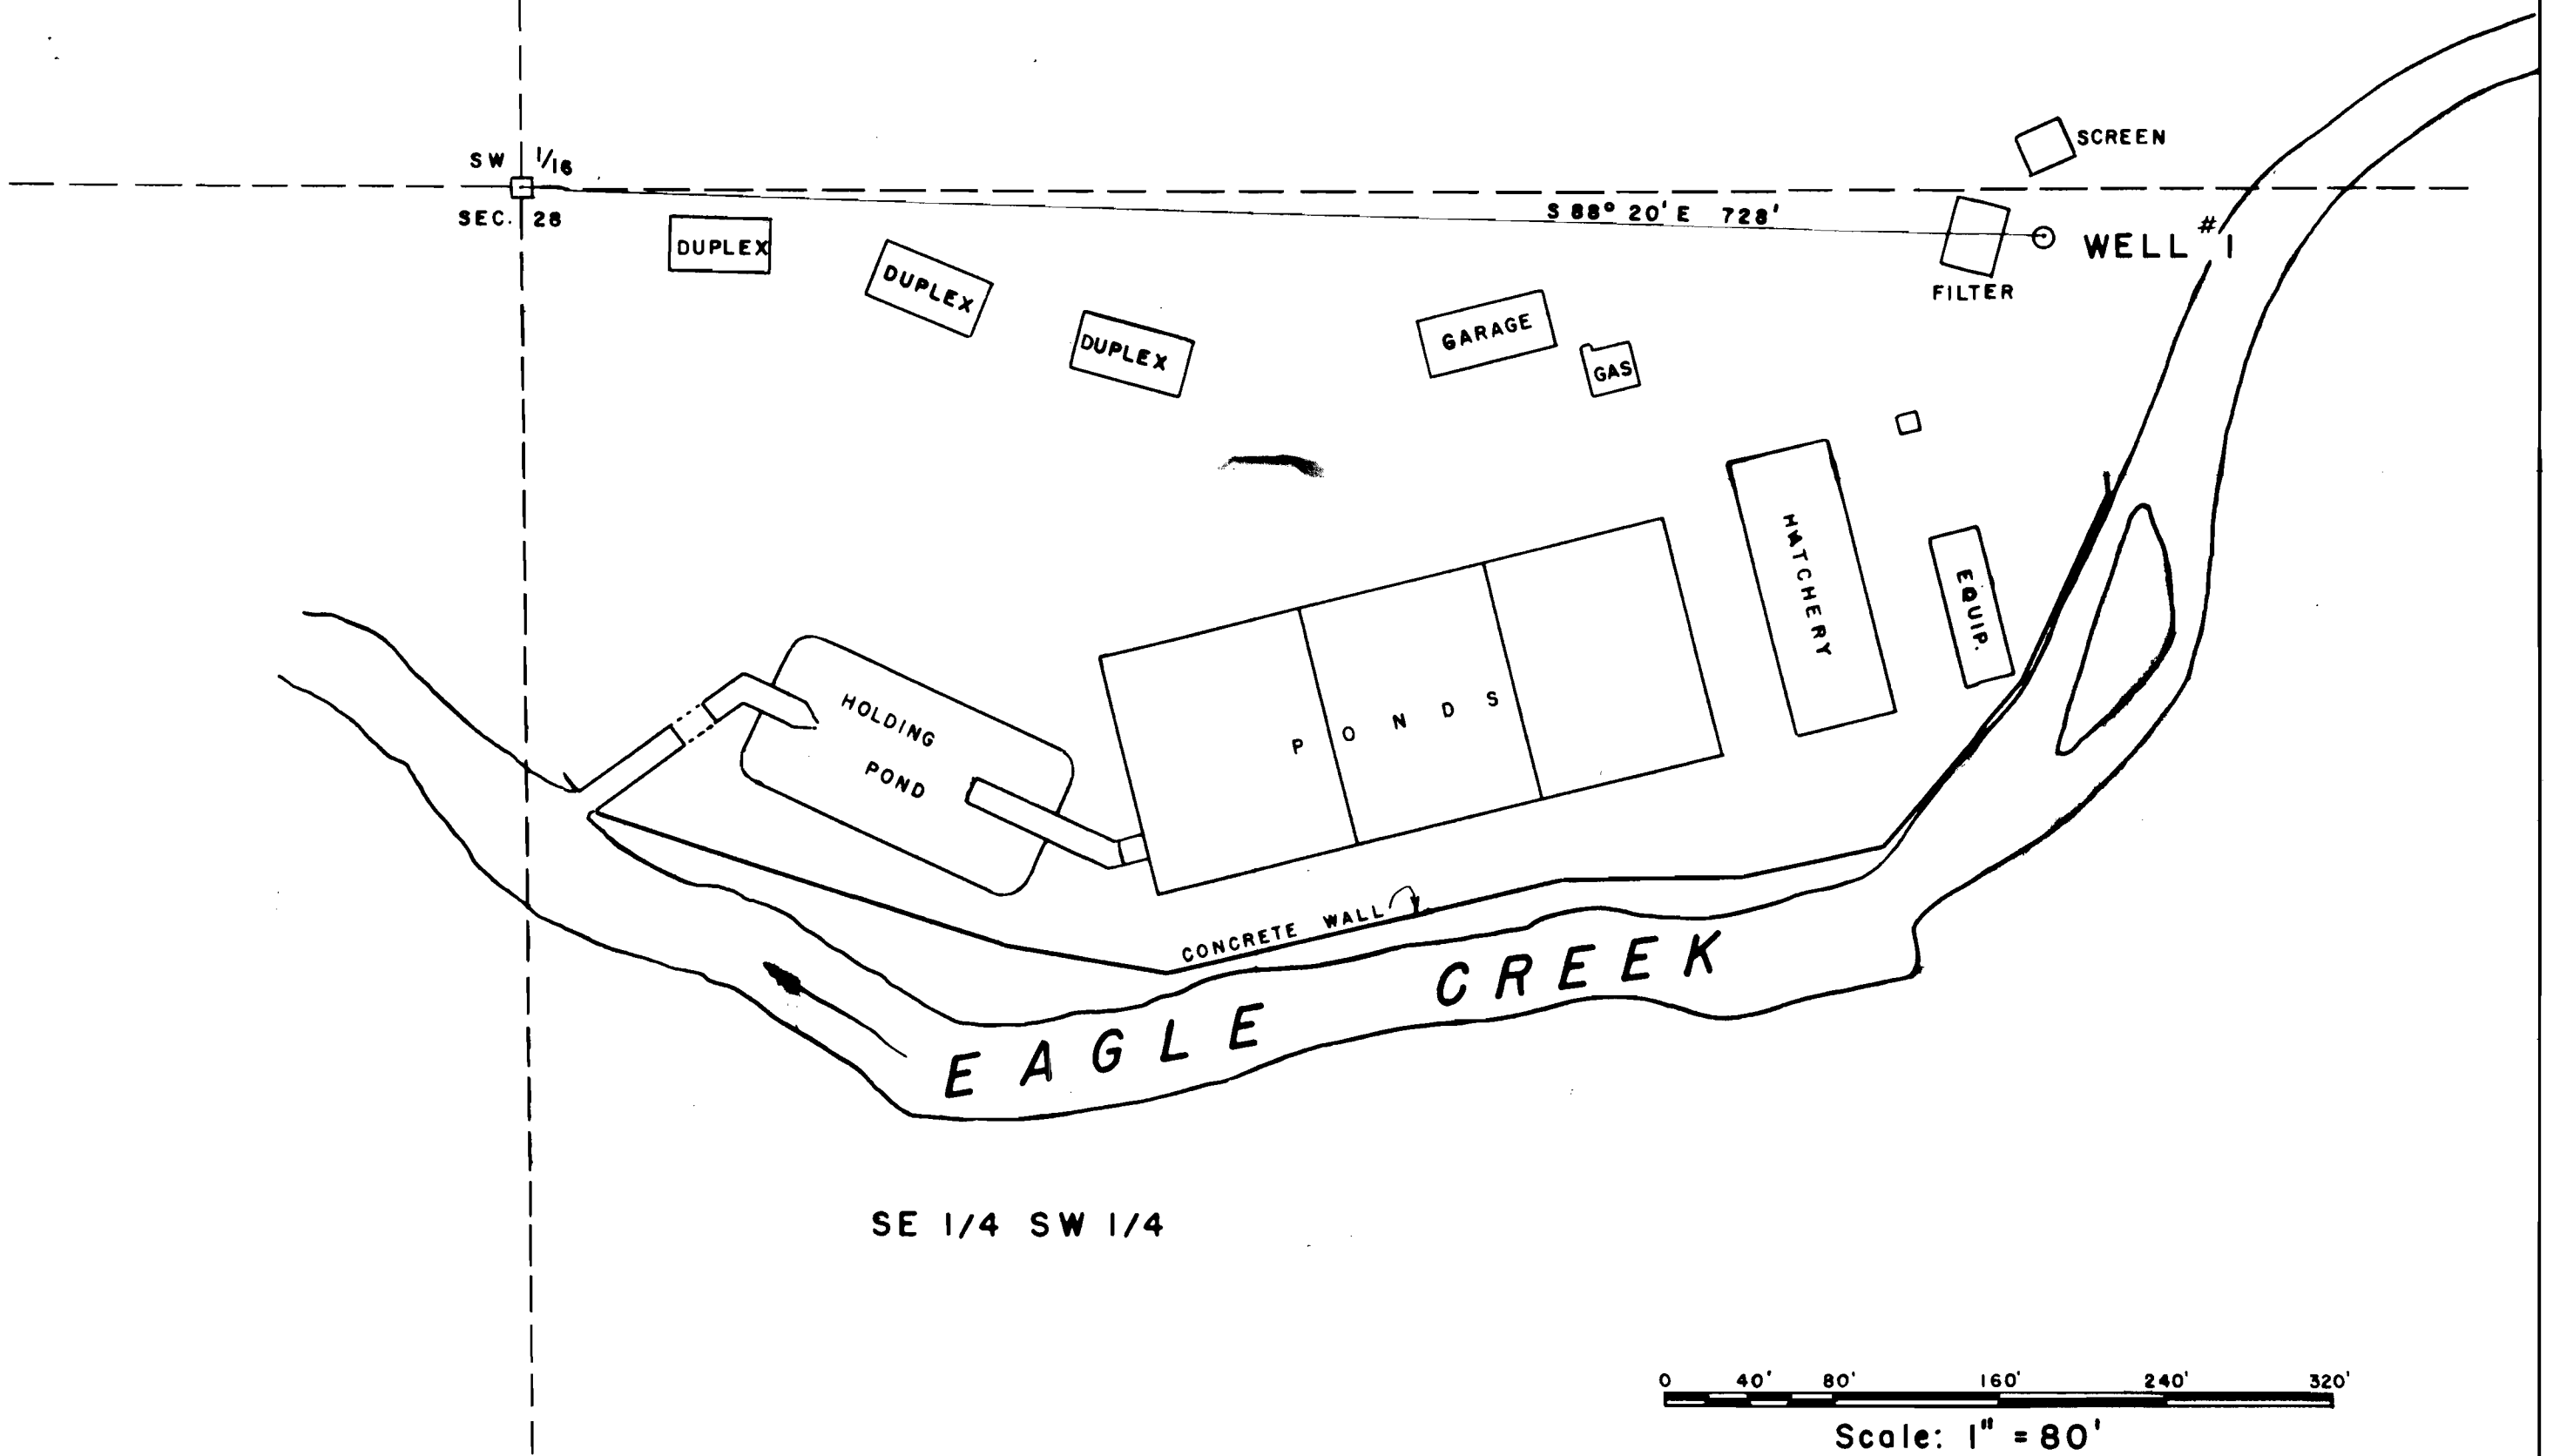

SE 1/4 SW 1/4

0 40' 80' 160' 240' 320'
Scale: 1" = 80'

WILLAMETTE MERIDIAN

MAP TO ACCOMPANY
APPLICATION TO APPROPRIATE WATER
FOR FISH CULTURAL PURPOSES
BY
U.S. DEPARTMENT OF THE INTERIOR
FISH AND WILDLIFE SERVICE
FROM
WELL NO.1

G-33-15
G-3334