

W.R. 375

M. E. WINN


SEC. 13, T. 10 S., R. 4 W., W.M.

LINN COUNTY, OREGON

Scale: 1" = 10 Chains

July 28, 1956

ORRIS A. CARNEGIE  
DEP. CO. SURVEYOR

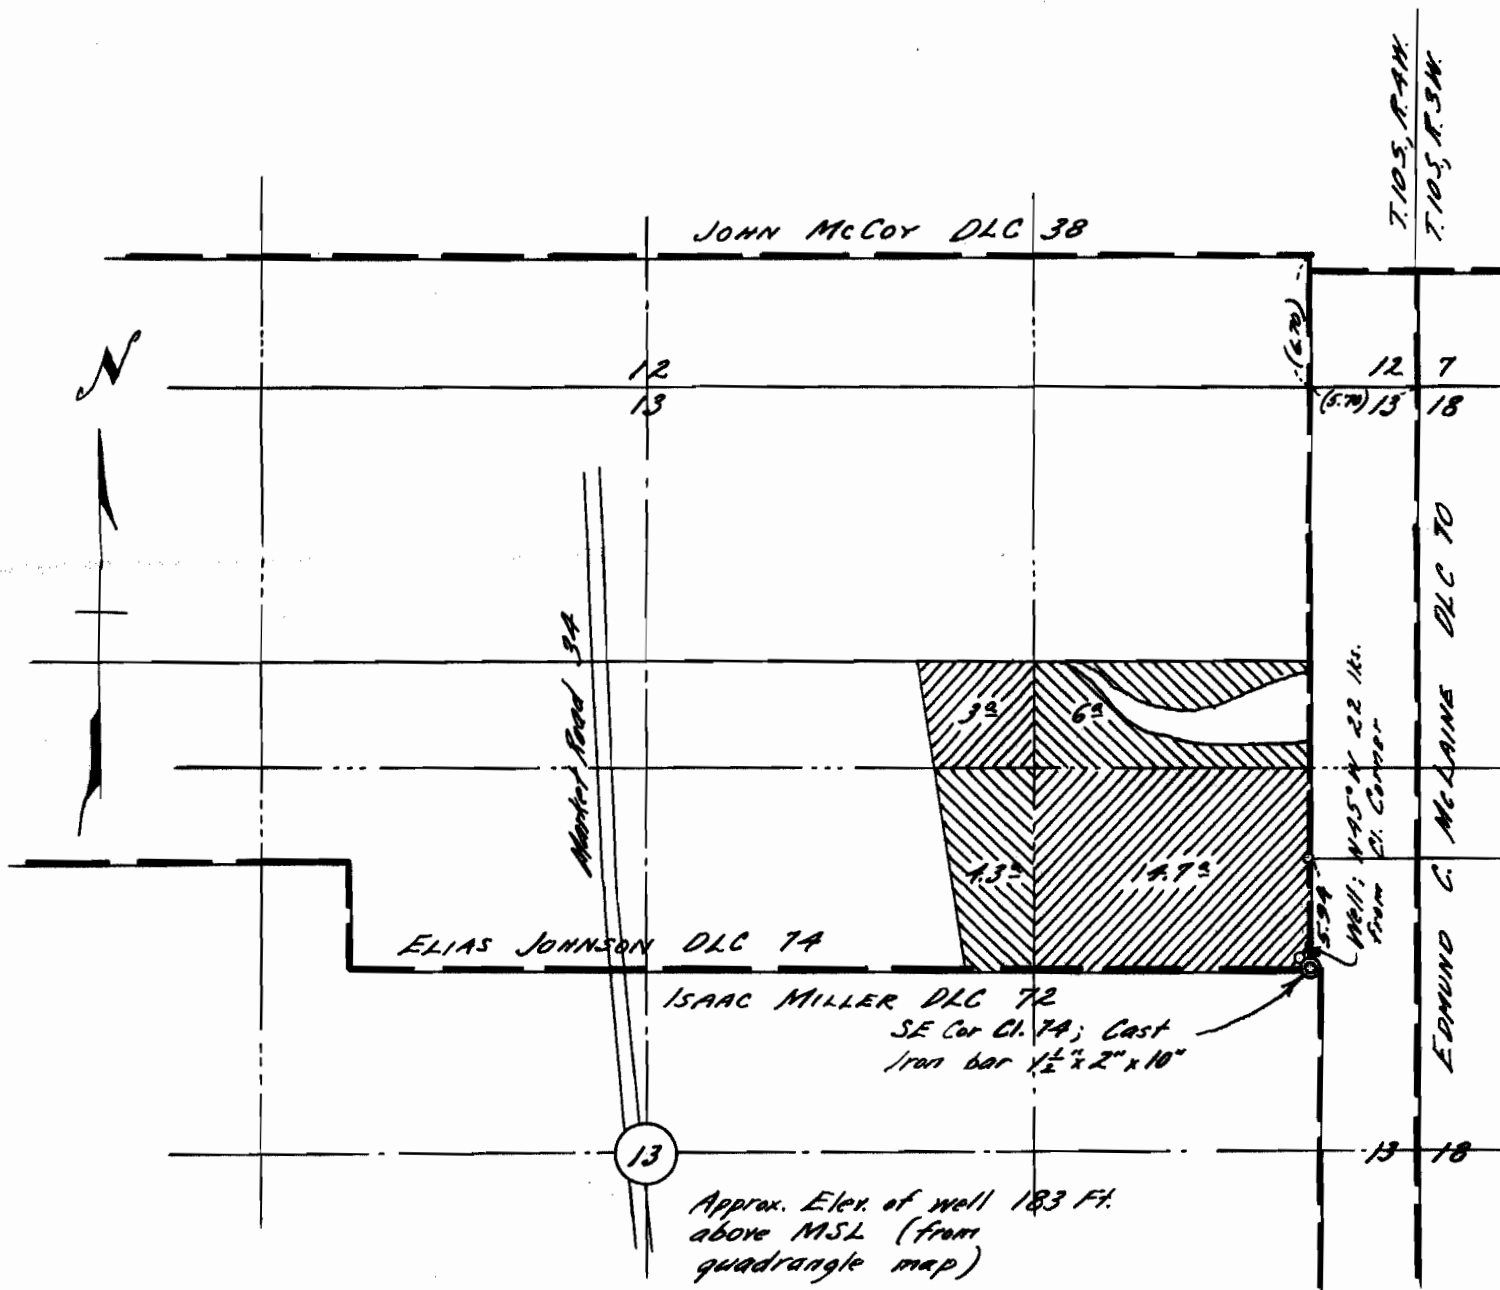

Application No. G-449  
Permit No. G-334

REGISTERED  
OREGON  
LAND SURVEYOR

*Orris A. Carnegie*

MAY 9, 1947  
ORRIS A. CARNEGIE  
213