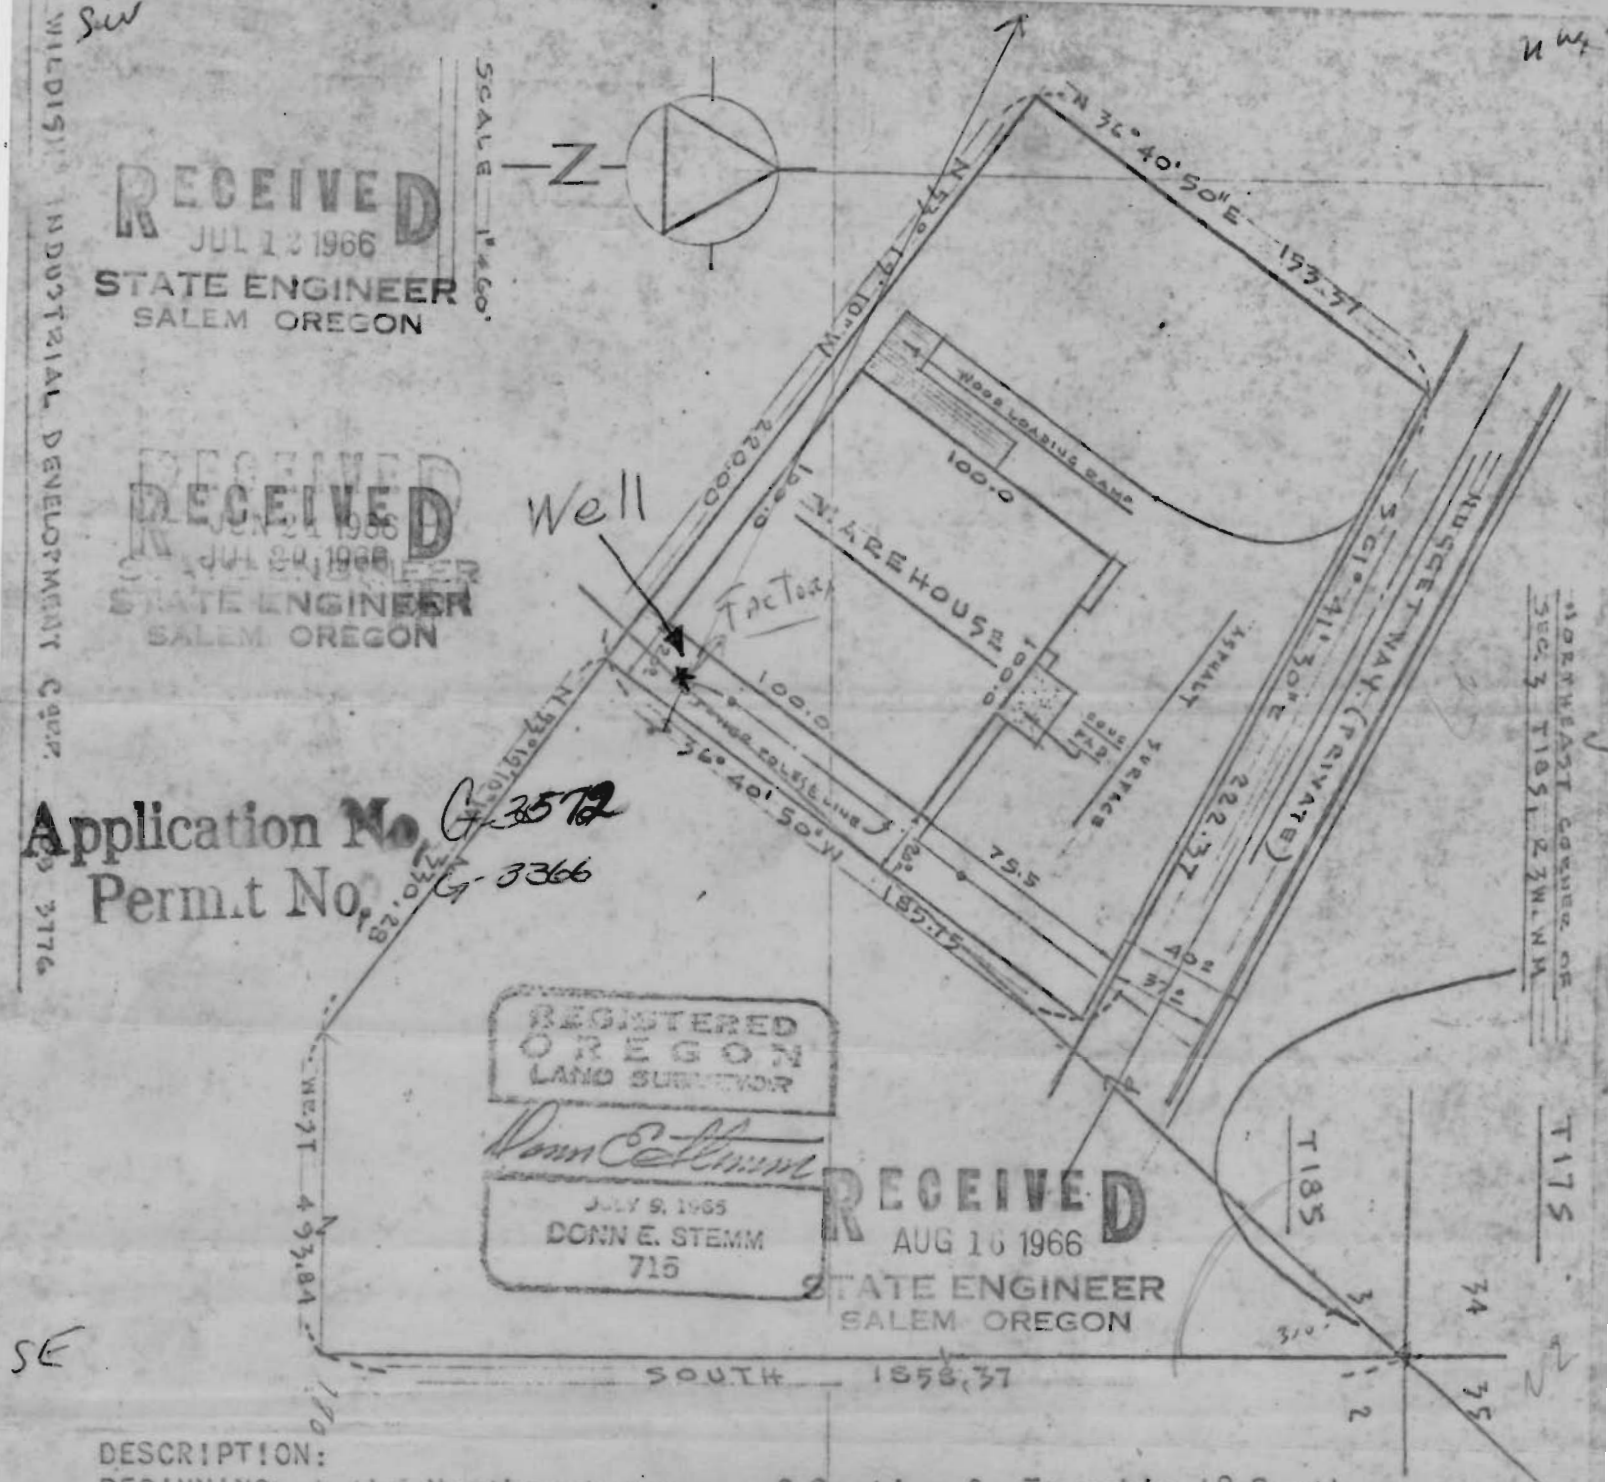

DESCRIPTION:
BEGINNING at the Northeast corner of Section 3, Township 18 South, Range 3 West of the Willamette Meridan, run thence South 1858.37 feet along the East line of said Section 3, thence West 493.84 feet, thence North 53° 19' 10" West 330.28 feet to the True Point of Beginning, run thence North 53° 19' 10" West 220.00 feet, thence North 36° 40' 50" East 153.37 feet, thence South 61° 41' 30" East 222.37 feet, thence South 36° 40' 50" West 185.75 feet to the True Point of Beginning, all in Lane County, Oregon.

I, Donn E. Stemm, registered Land Surveyor, certify that I have surveyed the above described property and find said property as shown above with buildings thereon located as shown, and I find no part of any building encroached on the adjacent property nor does any part of any building on the adjacent property encroach on the above described property.

Survey for: Wildish Industrial Development Corp.