

W.R. 926

ALBANY FROZEN FOODS, INC.

SEC. 18, T. 11 S., R. 3 W., W.M.

LINN CO., ORE.

Scale: 1" = 400'


August 31, 1966

Orris A. Carnegie
County Surveyor

REGISTERED
OREGON
LAND SURVEYOR

Orris A. Carnegie

MAY 9, 1947
ORRIS A. CARNEGIE
213

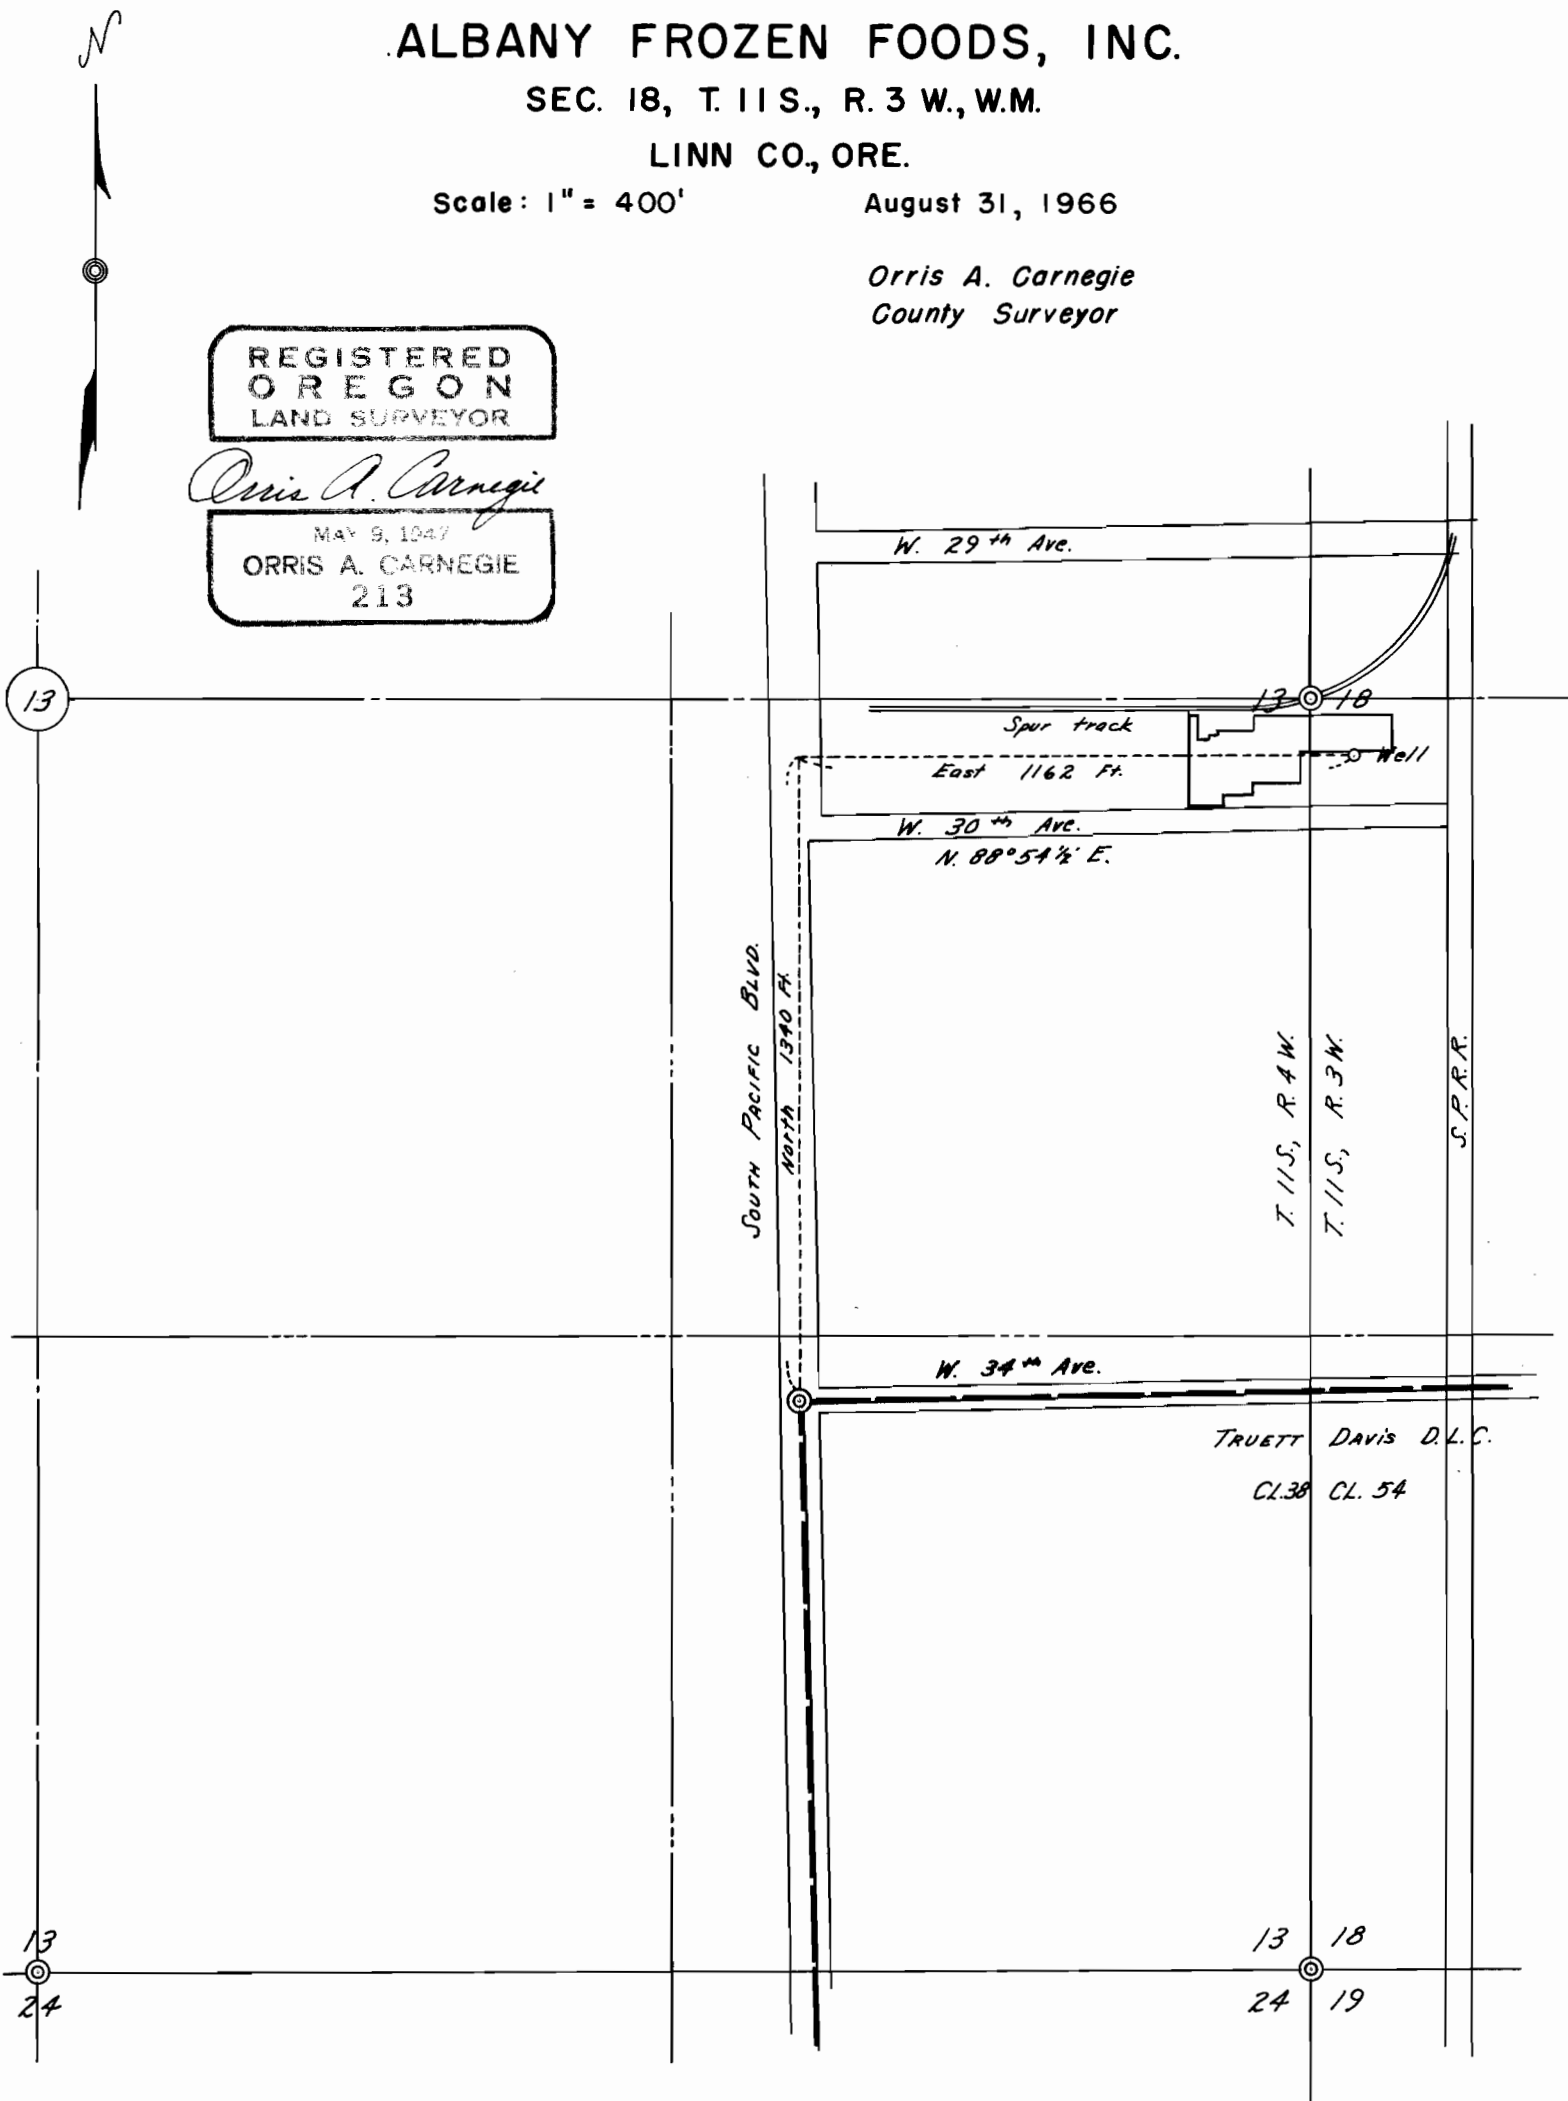

Elev. of well site approx. 225 Ft. above M.S.L.
(from U.S.G.S. Map)

This map drawn from County Records (C.S. 8931)

Applicant: Albany Frozen Foods, Inc. G-3583.
C 3373