


T 3 S. R 1 W
Scale 1" = 200'

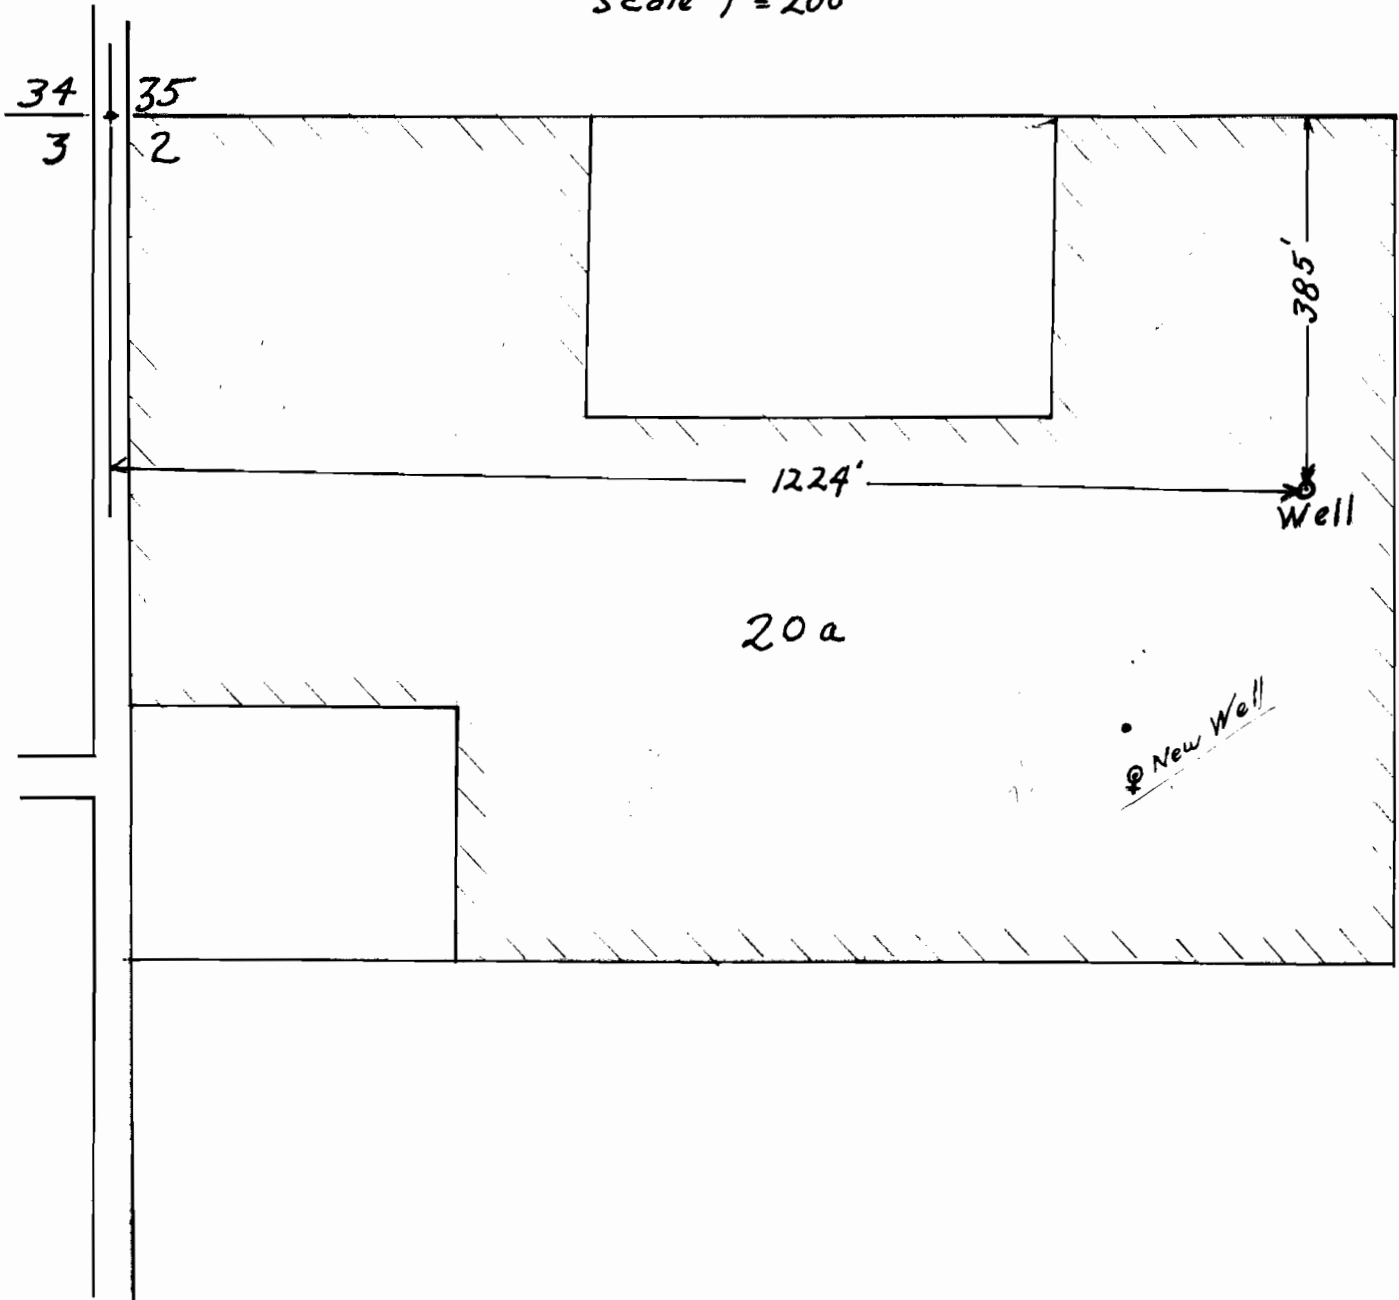

Application No. G-3698
Permit No. G-3500

Handwritten initials or mark.

G-2422

G-2259