


# T.4&5 S.R.3 W.W.M.

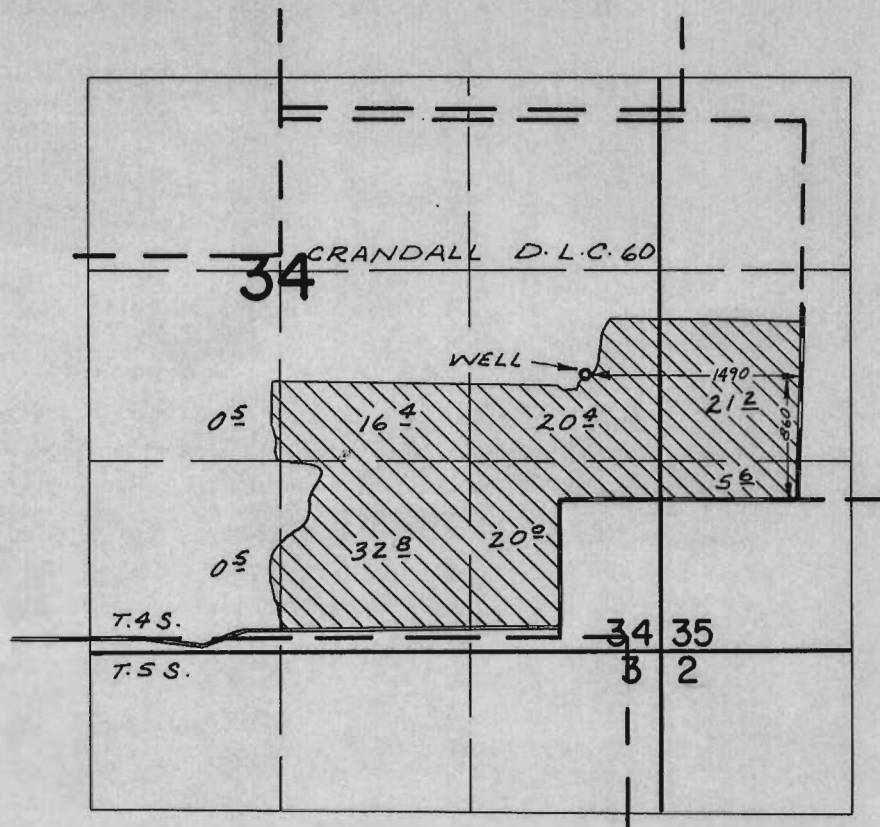

## FINAL PROOF SURVEY UNDER

Application No. G-3767 Permit No. G-3553  
IN NAME OF

ALLEN AND ANDREW NICHOLS

Surveyed Nov. 9, 1972, by R. MUCKEN