


WATER RIGHT SURVEY

FOR

ARTHUR C. JAEGER

T. 5 S. R. 1 W M Sec. 8 Marion County,
Oregon.

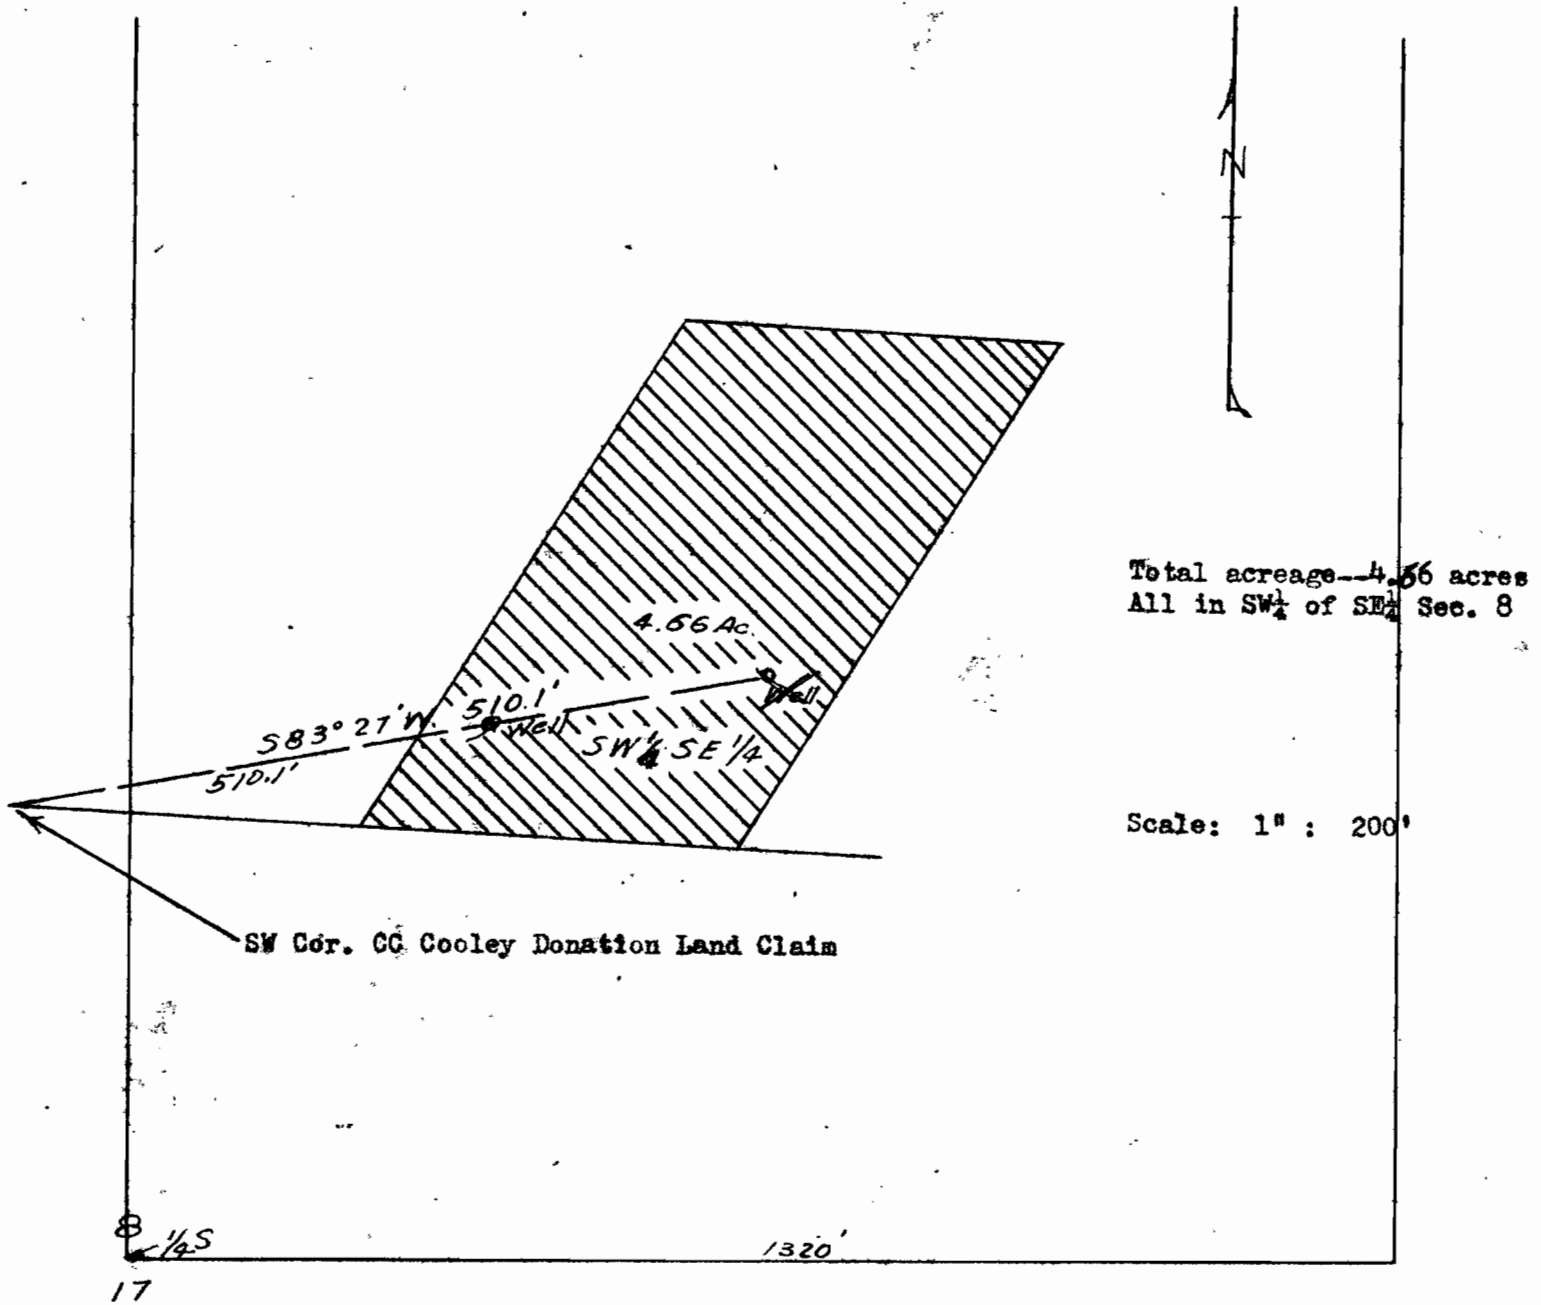

Drawing made by David F. Bates LAND SURVEYOR 477 Court Street Salem, Oregon.
Location of well computed from measurements given by applicant.

REGISTERED
OREGON
LAND SURVEYOR

David F. Bates

JULY 7, 1944
DAVID F. BATES
24

Application No. G-498
Permit No. G-358