



# T.12&13S., R.5W., W.M.

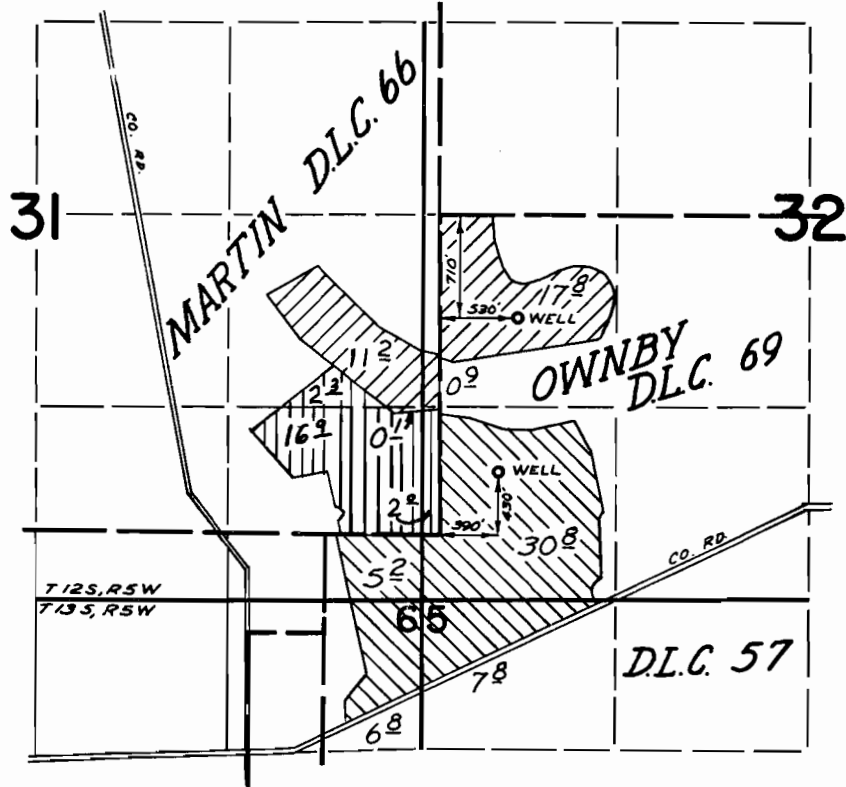

## FINAL PROOF SURVEY UNDER

Tr. 3171  
 G-3806  
 Application No. G-4331 Permit No. G-4086  
 IN NAME OF

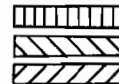

LEIGHTON DAVIS

Surveyed OCT 4 76 by C.R. King  
MARCH 27 1973 by D. NORBY